

Harrison  
N 306  
7-17-82

MISSISSIPPI DEPARTMENT OF NATURAL RESOURCES  
Bureau of Land and Water Resources  
Southport Mall  
P.O. Box 10631  
Jackson, Mississippi 39209  
WATER WELL DRILLERS LOG

0000

7-17 1982 BRADEN Pump & Well HARRISON  
date well completed firm name county well located  
SERVICE, INC.

LANDOWNER: ELMER Scott  
Hesslers Street  
Pass Christian, MS - 39571  
(mailing address)

WELL LOCATION:  
sec. 27 T 8 S R 13 E  
1 miles W of Pass Christian  
(distance) (direction) (nearest town)

WELL PURPOSE: ~~Home~~ Industrial  
(Home, Irrigation, Municipal, Industrial)  
SPRINKLER SYSTEM

- WELL COMPLETION DATA:
- diameter (inches) 4 X 2
  - total depth (feet) 870
  - static water level (feet) 0 below top of ground
  - casing (material) PVE (depth) 870  
4" X 2" (size) If telescope see back.
  - screen (length) 10 (depth to top) 870  
2" (size) PVE (material) (006)
  - pump (HP) 1 (yield gpm) 20  
200 V 1 P (type power)
  - electric log (yes or no) No  
(organization running log)
  - how well bottom plugged PVE Sand Shark

description of formations encountered	depth	
	from	to
CLAY	0	10
SAND	10	60
CLAY	60	160
SAND	160	175
CLAY	175	230
SAND	230	240
CLAY	240	340
SAND	340	350
CLAY	350	420
SAND	420	428
CLAY	428	680
(FINE) SAND	680	760
CLAY	760	780
SAND	780	800
CLAY	800	840
SAND	840	880

DEPT. OF NATURAL RESOURCES  
BUREAU OF LAND & WATER RESOURCES



JUL 20 1982  
JUL 29 1982

RECEIVED

DRILLERS REMARKS:  
No TAIL PIPE

If well telescopes please sketch and show depths.

GROUND LEVEL

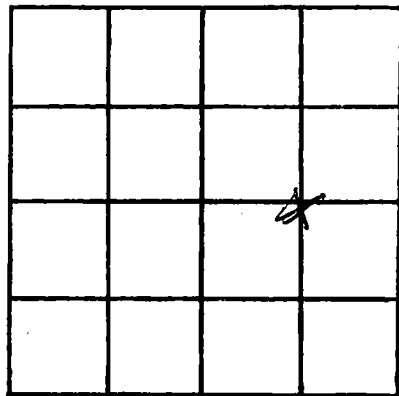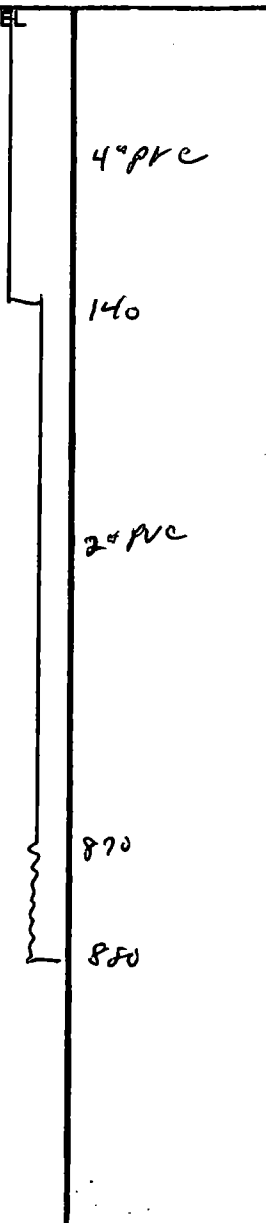

SECTION 27

Please indicate well location X.

ADDITIONAL INFORMATION

If more than one screen, show locations of each on sketch.