

MISSISSIPPI DEPARTMENT OF NATURAL RESOURCES

Bureau of Land and Water Resources

Southport Mall

P.O. Box 10631

Jackson, Mississippi 39209

WATER WELL DRILLERS LOG

HARRISON
N 309
918182

9-8-82 19 Lynam Well Co. Harrison  
 date well completed firm name county well located

LANDOWNER: Mc Clendon  
Companies Box 399  
Pass Christian 39571  
 (mailing address)

description of formations encountered	from to	
Sand + Gravel	0	100
Blue Clay	100	200
Gold Sand	200	258

WELL LOCATION:

sec. 12 T. 8 N. R. 13 E.  
5 miles N off Pass Christian  
 (distance) (direction) (nearest town)

WELL PURPOSE:

(home, irrigation, municipal, industrial)

WELL COMPLETION DATA:

- (1) diameter (inches) 2"
- (2) total depth (feet) 258'
- (3) static water level (feet) 1' <sup>below</sup> ~~above~~ top of ground.
- (4) casing PVC, 258'  
 (material) (depth)  
2" If telescope see back.  
 (size)
- (5) screen 10', 258'  
 (length) (depth to top)  
2" PVC  
 (size) (material)
- (6) pump 1/2, 25  
 (HP) (yield gpm)  
Elect  
 (type power)
- (7) electric log NO  
 (yes or no)  
NO  
 (organization running log)

**CODED**

(8) how well bottom planned Back  
Wash Valve

DRILLERS REMARKS:


DEPT. OF NATURAL RESOURCES  
 BUREAU OF LAND & WATER RESOURCES

FEB 28 1983

**RECEIVED**

If well telescopes please sketch and show depths.

GROUND LEVEL

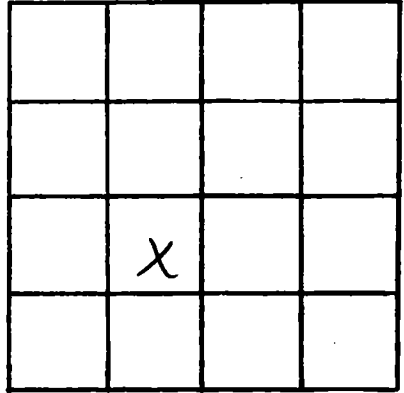

SECTION 12

Please indicate well location X.

ADDITIONAL INFORMATION

If more than one screen, show locations of each on sketch.