

MISSISSIPPI DEPARTMENT OF NATURAL RESOURCES

Bureau of Land and Water Resources

Southport Mall

P.O. Box 10631

Jackson, Mississippi 39209

WATER WELL DRILLERS LOG

CODED

HARRISON
N 310
6125183

6/25 1983
date well completed

Braden Pump & Well Serv. Inc.
firm name

Harrison
county well located

LANDOWNER: Mrs. J. Walker Murphy
3125 Calion Rd
El Dorado, Ark. 71730
(mailing address)

description of formations encountered

from to

WELL LOCATION:

sec. 33 T 8 S R. 13 E W
2 miles W of Pass Christian
(distance) (direction) (nearest town)

blue clay	0	20
sand	20	60
blue clay	60	75
sand	75	80
clay	80	90
sand	90	120
clay	120	125
sand	125	180
clay	180	280
sand	280	285
clay	285	340
sand	340	350
clay	350	400
sand & clay	400	480
sand	480	500

WELL PURPOSE: home
(home, irrigation, municipal, industrial)

WELL COMPLETION DATA:

- (1) diameter (inches) 4"
- (2) total depth (feet) 500
- (3) static water level (feet) 0 below top of ground.
- (4) casing PVC, 485 (material), (depth)
4" (size) If telescope see back.
- (5) screen 10, 485 (length), (depth to top)
4" PVC underbar (size), (material)
- (6) pump 5 (HP), 90 (yield gpm)
220V 1Ø (type power)
- (7) electric log NO (yes or no)

(organization running log)

(8) how well bottom plugged PVC sandbars

CODED

DEPT. OF NATURAL RESOURCES
BUREAU OF LAND & WATER RESOURCES


JUN 15 1983

RECEIVED

DRILLERS REMARKS: 5 ft. tailpipe

If well telescopes please sketch and show depths.

GROUND LEVEL

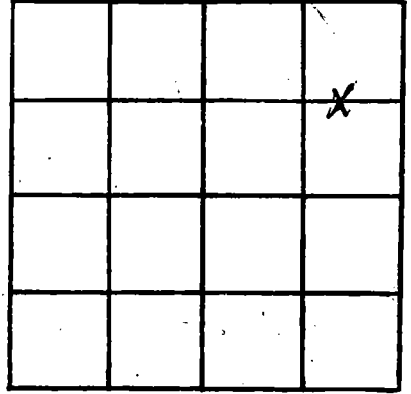

SECTION 33

Please indicate well location X.

ADDITIONAL INFORMATION

If more than one screen,
show locations of each on sketch.