

MISSISSIPPI DEPARTMENT OF NATURAL RESOURCES

Bureau of Land and Water Resources

Southport Mall

P.O. Box 10631

Jackson, Mississippi 39209

WATER WELL DRILLERS LOG

CODED

N 312  
 HARRISON  
 6-28-83

6/28 1983 Thymon Well Co. HARRISON  
 date well completed firm name county well located

LANDOWNER:	description of formations encountered	from	to
William John	Red Sand Gravel	0	40
Rt. 3, Box 656	Blue Gravelly Clay	40	230
Pass, Christian, Miss 39571	fine sand	230	270
WELL LOCATION:	Blue Clay	270	409
sect 15 T 8 N R 13 E	fine sand	409	458
9 miles N of Pass, Christian	Blue Clay	458	516
(distance) (direction) (nearest town)	fine sand	516	564
WELL PURPOSE: <u>Home</u>	Good sand	564	602
(home, irrigation, municipal, industrial)			
WELL COMPLETION DATA:			
(1) diameter (inches) <u>4x2</u>			
(2) total depth (feet) <u>602</u>			
(3) static water level (feet) <u>55</u> below above top of ground.			
(4) casing <u>PVC</u> , <u>582</u> , (material) (depth)			
<u>4x2</u> If telescope see back. (size)			
(5) screen <u>20</u> , <u>602</u> (length) (depth to top)			
<u>2"</u> , <u>PVC</u> (size) (material)			
(6) pump <u>1</u> , <u>34</u> (HP) (yield gpm)			
<u>Elect.</u> (type power)			
(7) electric log <u>NO</u> (yes or no)			
<u>NO</u> (organization running log)			
(8) how well bottom plugged <u>Sand Shale</u>			
DRILLERS REMARKS:			


DEPT. OF NATURAL RESOURCES  
 BUREAU OF LAND & WATER RESOURCES

NOV - 3 1983

RECEIVED

If well telescopes please sketch and show depths.

GROUND LEVEL

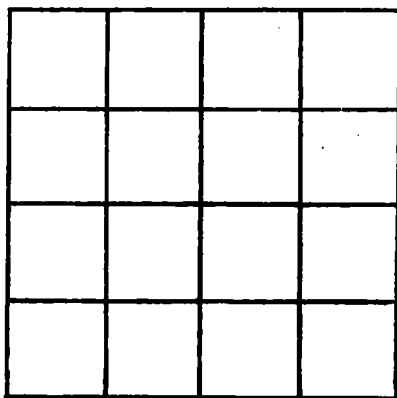

SECTION \_\_\_\_\_

Please indicate well location X.

ADDITIONAL INFORMATION

If more than one screen, show locations of each on sketch.