

MISSISSIPPI DEPARTMENT OF NATURAL RESOURCES  
Bureau of Land and Water Resources

Southport Mall

P.O. Box 10631

Jackson, Mississippi 39209

WATER WELL DRILLERS LOG

**CODED**

N 315  
HARRISON  
7-30-83

7/30/83  
date well completed

Lipman Well Co.  
firm name

Harrison  
county well located

LANDOWNER: Mr. Davis  
Arcadia Rd  
Pass Christian  
(mailing address)

description of formations encountered	from	to
Clay	0	120
Sand	120	200
Gumbo clay	200	350
Fine sand	350	400
Clay	400	560
Big sand	560	602

WELL LOCATION:  
sec. 11 T. 8 N. R. 13 E.  
(S) (W)  
2 miles N of Pass Christian  
(distance) (direction) (nearest town)

WELL PURPOSE: Home  
(home, irrigation, municipal, industrial)

WELL COMPLETION DATA:

(1) diameter (inches) 2"

(2) total depth (feet) 602'

(3) static water level (feet) +3' below above top of ground.

(4) casing PVC, 592'  
(material) (depth)

2"  
(size) If telescope see back.

(5) screen 10', 592'  
(length) (depth to top)

2", PVC  
(size) (material)

(6) pump 1 (HP) (yield gpm)  
electric  
(type power)

(7) electric log NO  
(yes or no)  
NO  
(organization running log)

(8) how well bottom plugged sand  
shark

DEPT. OF NATURAL RESOURCES  
BUREAU OF LAND & WATER RESOURCES


APR 30 1984

**RECEIVED**

DRILLERS REMARKS:

If well telescopes please sketch and show depths.

GROUND LEVEL

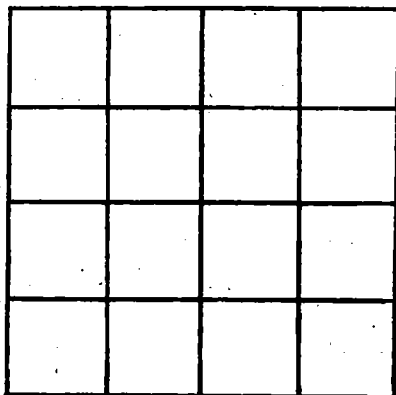

SECTION \_\_\_\_\_

Please indicate well location X.

ADDITIONAL INFORMATION

If more than one screen, show locations of each on sketch.