

MISSISSIPPI DEPARTMENT OF NATURAL RESOURCES

Bureau of Land and Water Resources

Southport Mall

P.O. Box 10631

Jackson, Mississippi 39209

WATER WELL DRILLERS LOG

CODED

N 316
 HARRISON
 12-5-83

12/5/83 19 Lyman Well Co. Harrison
 date well completed firm name county well located

LANDOWNER: Thurway Keel, Jr.
 (mailing address)

description of formations encountered	from	to
<u>Red Sand & Gravel</u>	<u>0</u>	<u>90</u>
<u>Pine Sand & Grey Gumbo</u>	<u>90</u>	<u>140</u>
<u>Pine Sand & Blue Clay</u>	<u>140</u>	<u>200</u>
<u>Blue Gumbo</u>	<u>200</u>	<u>450</u>
<u>Good Sand</u>	<u>450</u>	<u>575</u>

WELL LOCATION:
 sec. 2 T. 8 N. R. 13 E.
 (S) (W)
7 miles N of Pass Christian
 (distance) (direction) (nearest town)

WELL PURPOSE: Arms
 (home, irrigation, municipal, industrial)

WELL COMPLETION DATA:

(1) diameter (inches) 2"

(2) total depth (feet) 515'

(3) static water level (feet) +5 below above
 top of ground.

(4) casing PVC, 505'
 (material) (depth)
2"
 (size) If telescope see back.

(5) screen 10', 505'
 (length) (depth to top)
2", PVC
 (size) (material)

(6) pump 1, 28
 (HP) (yield gpm)
electric
 (type power)

(7) electric log No
 (yes or no)
No
 (organization running log)

(8) how well bottom plugged sand
shark

DEPT. OF NATURAL RESOURCES
 BUREAU OF LAND & WATER RESOURCES


APR 26 1984

RECEIVED

DRILLERS REMARKS:

If well telescopes please sketch and show depths.

GROUND LEVEL

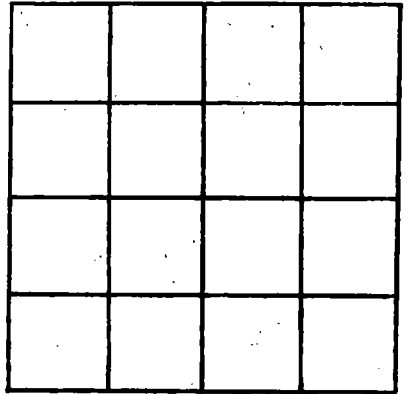

SECTION _____

Please indicate well location X.

ADDITIONAL INFORMATION

If more than one screen, show locations of each on sketch.