

**MISSISSIPPI DEPARTMENT OF NATURAL RESOURCES**  
**Bureau of Land and Water Resources**  
 Southport Mall  
 P.O. Box 10631  
 Jackson, Mississippi 39209  
**WATER WELL DRILLERS LOG**

N317  
 HARRISON  
 2-23-83

CODED

2/23/83 19 Syman Well Harrison  
 date well completed firm name county well located

LANDOWNER Shattles Const.  
102 Dovercliff Rd  
Hattiesburg  
 (mailing address)

description of formations encountered	from	to
Gravel & white Clay	0	60
Fine Sand Gumbo Clay	60	80
Grey Gumbo	80	200
Fine Sand & Clay	200	260
Hard Blue Clay	260	340
medium Red Sand	340	368
Blue Clay	368	440
Hard Blue Clay	440	463
+ fine sand		
Hard Sand	463	506

WELL LOCATION:  
 sec. 11 T. 8 N. R. 13 E.  
3 miles N of Pass Christian  
 (distance) (direction) (nearest town)

WELL PURPOSE: Home  
 (home, irrigation, municipal, industrial)

WELL COMPLETION DATA:

(1) diameter (inches) 2"

(2) total depth (feet) 516'

(3) static water level (feet) 13 below above top of ground.

(4) casing PVC, 506'  
 (material) (depth)  
2" if telescope see back.  
 (size)

(5) screen 10', 506  
 (length) (depth to top)  
2", PVC  
 (size) (material)

(6) pump 1/2 28  
 (HP) (yield gpm)  
electric  
 (type power)

(7) electric log NO  
 (yes or no)  
NO  
 (organization running log)

(8) how well bottom plugged sand  
Shark

DEPT. OF NATURAL RESOURCES  
 BUREAU OF LAND & WATER RESOURCES


MAY 11 1984

**RECEIVED**

DRILLERS REMARKS:

If well telescopes please sketch and show depths.

GROUND LEVEL

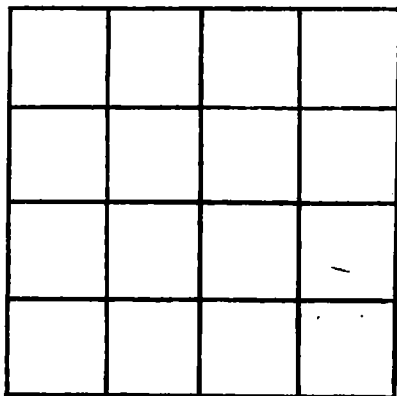

SECTION \_\_\_\_\_

Please indicate well location X.

ADDITIONAL INFORMATION

If more than one screen,  
show locations of each on sketch.