

MISSISSIPPI DEPARTMENT OF NATURAL RESOURCES

Bureau of Land and Water Resources

Southport Mall

P.O. Box 10631

Jackson, Mississippi 39209

WATER WELL DRILLERS LOG

CODED

HARRISON
N 321
7-8-81

7/8/81 date well completed
Lynnan Well Co. firm name
Harrison county well located

LANDOWNER: Jack McDermott
P.O. Box 154
Long Beach, Md 39560
(mailing address)

WELL LOCATION:
sec. 2 T 8 N R 13 E
5 miles NW of Pass Christian
(distance) (direction) (nearest town)

WELL PURPOSE: Home
(home, irrigation, municipal, industrial)

- WELL COMPLETION DATA:
- (1) diameter (inches) 4x2
 - (2) total depth (feet) 760'
 - (3) static water level (feet) 10' below top of ground.
 - (4) casing PVC (material), (depth),
4x2 (size) if telescope see back.
 - (5) screen (length), (depth to top)
24 (size), PVC (material)
 - (6) pump 1 1/2 (HP), 18 (yield gpm)
electric (type power)
 - (7) electric log NO (yes or no)
NO (organization running log)
 - (8) how well bottom plugged sand shark

Description of formations encountered	from	to
Sand with	0	6
gray clay	6	80
with sand	80	70
gray & blue clay	70	310
gray fine	310	340
clay	340	680
sand fine	680	760

DEPT. OF NATURAL RESOURCES
BUREAU OF LAND & WATER RESOURCES


OCT 20 1981

RECEIVED

DRILLERS REMARKS:

If well telescopes please sketch and show depths.

GROUND LEVEL

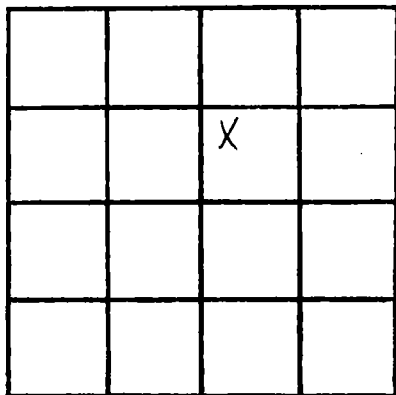

SECTION 2

Please indicate well location X.

ADDITIONAL INFORMATION

8100130
A8:37
RECEIVED

If more than one screen, show locations of each on sketch.