

MISSISSIPPI DEPARTMENT OF NATURAL RESOURCES

Bureau of Land and Water Resources

Southport Mall

P.O. Box 10631

CODED

Jackson, Mississippi 39209

WATER WELL DRILLERS LOG

Harrison  
N324  
1-10-85

1-10-85

date well completed

19

Mc Gill Well Works

firm name

HARRISON

county well located

LANDOWNER: Howard Norton  
Rt. 5 Box 642  
Gulfport Ms  
 (mailing address)

WELL LOCATION:  
 sec. 26 T. 8 N. R. 13 E.  
6 miles W of PASS CR.  
 (distance) (direction) (nearest town)

WELL PURPOSE:  
 (home, irrigation, municipal, industrial)

WELL COMPLETION DATA:

- (1) diameter (inches) 2"  
 (2) total depth (feet) 280'  
 (3) static water level (feet) 70 below  
 top of ground.  
 (4) casing Pvc Sch. 40, 270'  
 (material) (depth)

\_\_\_\_\_ if telescope see back.  
 (size)

- (5) screen 10', 270'  
 (length) (depth to top)  
2", Sch 80 6 slot  
 (size) (material)

- (6) pump 1 7  
 (HP) (yield gpm)

ELEC.  
 (type power)


- (7) electric log \_\_\_\_\_  
 (yes or no)

\_\_\_\_\_ (organization running log)

- (8) how well bottom plugged SAND  
SHARK

DRILLERS REMARKS:


description of formations encountered	from	to
Mud <b>CODED</b>	0	20
Mud	20	40
Mud/Sand	40	60
Sand	60	80
Sand/Mud	80	100
Sand/Mud	100	120
Sand/Mud	120	140
Sand/Mud	140	160
Mud	160	180
Mud	180	200
Mud/Sand	200	220
Mud	220	240
Mud/Sand	240	260
Sand	260	280

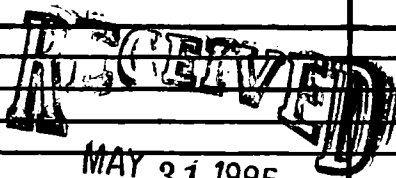

Department of Natural Resources  
 Bureau of Land & Water Resources

If well telescopes please sketch and show depths.

GROUND LEVEL

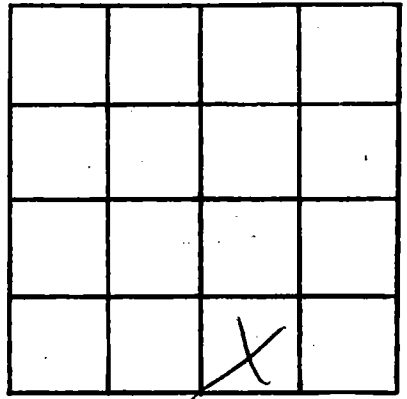

SECTION \_\_\_\_\_

Please indicate well location X.

ADDITIONAL INFORMATION

If more than one screen,  
show locations of each on sketch.