

MISSISSIPPI DEPARTMENT OF NATURAL RESOURCES

Bureau of Land and Water Resources

Southport Mall

P.O. Box 10631

Jackson, Mississippi 39209 **CODED**

WATER WELL DRILLERS LOG

Harrison
N 325
12-28-84

12-28 1984 Mc Hill Well Works Harrison
 date well completed firm name county well located

LANDOWNER: James McQuinn Jr
305 Magnolia Lane
Pass Christian, Ms. 39571
 (mailing address)

description of formations encountered	from	to
<u>mud</u> CODED	<u>0</u>	<u>20</u>
<u>mud</u>	<u>20</u>	<u>40</u>
<u>Sand Gravel</u>	<u>40</u>	<u>60</u>

WELL LOCATION:
 sec. 24 T 8 N R 13 E
4 miles E of Pass Christ.
 (distance) (direction) (nearest town)

WELL PURPOSE:
 (home, irrigation, municipal, industrial)

WELL COMPLETION DATA:

(1) diameter (inches) 2"

(2) total depth (feet) 60'

(3) static water level (feet) 10 ^{below} _{above} top of ground.

(4) casing 2 1/2" PVC 50'
 (material) (depth)

 if telescope see back.
 (size)

(5) screen 10' 50'
 (length) (depth to top)

2' Sch 80 1/2" slot
 (size) (material)

(6) pump 1/2
 (HP) (yield gpm)

 (type power)

(7) electric log
 (yes or no)

 (organization running log)

(8) how well bottom plugged Sand
SHARK


DRILLERS REMARKS:

RECEIVED
 MAY 31 1985

Department of Natural Resources
 Bureau of Land & Water

If well telescopes please sketch and show depths.

GROUND LEVEL

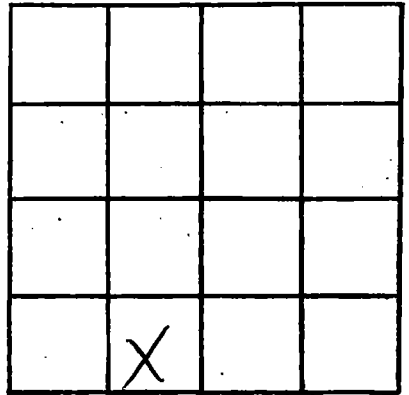

SECTION _____

Please indicate well location X.

ADDITIONAL INFORMATION

A series of horizontal lines for writing additional information.

If more than one screen, show locations of each on sketch.