

MISSISSIPPI DEPARTMENT OF NATURAL RESOURCES

Bureau of Land and Water Resources

Southport Mall

P.O. Box 10631

CODED

Jackson, Mississippi 39209

WATER WELL DRILLERS LOG

HARRISON
N 326

6/8/85
date well completed

19 Lyman Well Co
firm name

Harrison
county well located

LANDOWNER: Jack Clark
502 Edgewater Gulf Dr
Biloxi, Ms 39531
(mailing address)

description of formations encountered

from to

WHITE CLAY WHITE CLAY	0	20
BLUE CLAY	20	250
WHITE SAND	250	260
BLUE CLAY	260	700
CORSE BLUE SAND	700	735

WELL LOCATION:

sec. 26 T. 8 N R. 13 E
4 miles west of Southport
(distance) (direction) (nearest town)

CODED

WELL PURPOSE:

(home, irrigation, municipal, industrial)

WELL COMPLETION DATA:

- (1) diameter (inches) 4x2
- (2) total depth (feet) 735
- (3) static water level (feet) 73' below above top of ground.
- (4) casing PVC 715 (material) (depth) 4x2" (size) if telescope see back.
- (5) screen 20' 715' (length) (depth to top) 2" (size) PVC (material)
- (6) pump 1 1/2 (HP) 25 (yield gpm) electric (type power)
- (7) electric log NO (yes or no) NO (organization running log)
- (8) how well bottom plugged sand shack



RECEIVED
AUG 20 1985

Department of Natural Resources
Bureau of Land & Water Resources

DRILLERS REMARKS:

If well telescopes please sketch and show depths.

GROUND LEVEL

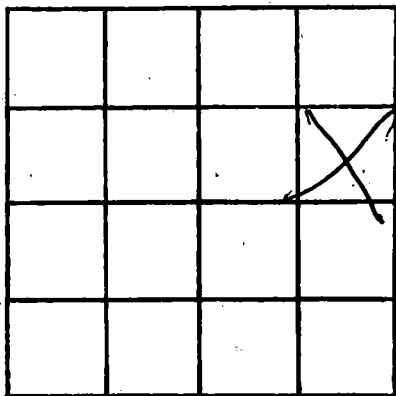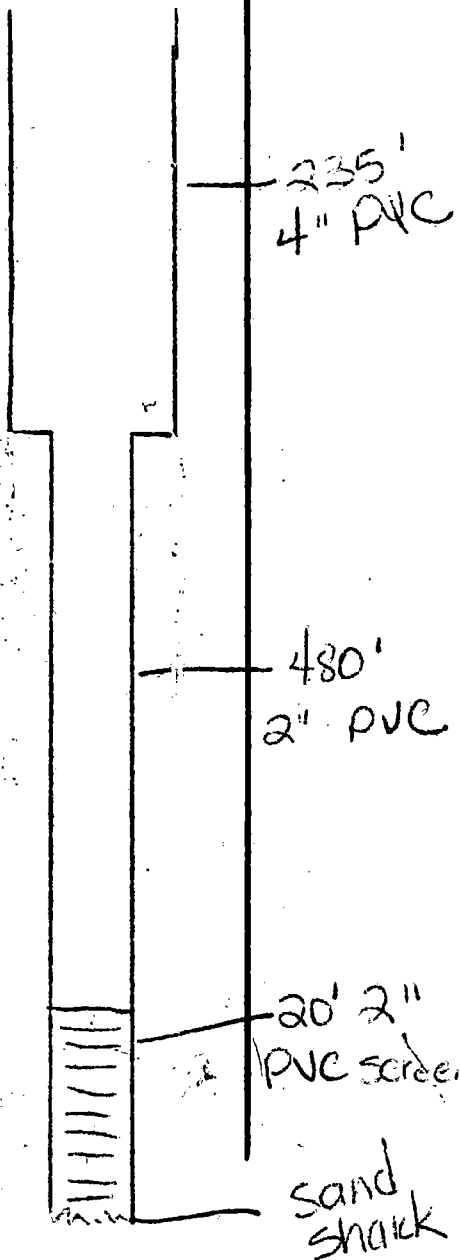

SECTION 26

Please indicate well location X.

ADDITIONAL INFORMATION

If more than one screen, show locations of each on sketch.