

MISSISSIPPI DEPARTMENT OF NATURAL RESOURCES

Bureau of Land and Water Resources

Southport Mall

P.O. Box 10631

Jackson, Mississippi 39209

WATER WELL DRILLERS LOG

Harrison
N 329
3-23-88

CODED

March 23 1988
 date well completed

LYNNE-CENTRAL Co.
 firm name

HARRISON
 county well located

LANDOWNER: <u>Dolphshore Baptist Assembly</u>	description of formations encountered	from	to
<u>Pass Christian, Miss.</u> (mailing address)	<u>Sand</u>	<u>0'</u>	<u>25'</u>
<u>WELL LOCATION:</u> sec. <u>33</u> T. <u>8</u> N S R. <u>13</u> E W	<u>Summer clay</u>	<u>25'</u>	<u>35'</u>
<u>WELL PURPOSE:</u> <u>Domestic</u> (home, irrigation, municipal, industrial)	<u>Sand</u>	<u>35'</u>	<u>70'</u>
<u>WELL COMPLETION DATA:</u>	<u>Sandy clay</u>	<u>70'</u>	<u>145'</u>
(1) diameter (inches) <u>10"</u>	<u>Clay & Gravel</u>	<u>145'</u>	<u>185'</u>
(2) total depth (feet) <u>965'</u>	<u>Clay & Sand streaks</u>	<u>185'</u>	<u>245'</u>
(3) static water level (feet) <u>Flow</u> below above top of ground.	<u>Hard clay</u>	<u>245'</u>	<u>315'</u>
(4) casing <u>Steel</u> (material) <u>965'</u> (depth)	<u>Clay & Sand & Gravel Strk.</u>	<u>315'</u>	<u>350'</u>
(5) screen <u>10"</u> (size) <u>60'</u> of <u>6"</u> (length) <u>965'</u> (depth to top)	<u>Sandy clay</u>	<u>350'</u>	<u>368'</u>
(6) pump <u>20 HP</u> (HP) <u>250</u> (yield gpm)	<u>Sand w/Clay Strk.</u>	<u>368'</u>	<u>517'</u>
(7) electric log <u>Yes</u> (yes or no)	<u>Sandy clay</u>	<u>517'</u>	<u>826'</u>
(8) how well bottom plugged <u>Back Pressure Valve</u>	<u>Sand w/Clay Strk.</u>	<u>826'</u>	<u>902'</u>
<u>DRILLERS REMARKS:</u>	<u>Sand</u>	<u>902'</u>	<u>961'</u>
<u>Permit No.</u>	<u>Sand w/Clay Strk.</u>	<u>961'</u>	<u>1002'</u>


RECEIVED

AUG 15 1988

Department of Natural Resources
 Bureau of Land & Water Resources

If well telescopes please sketch and show depths.

GROUND LEVEL

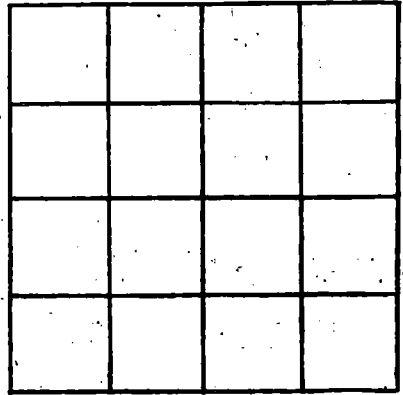

SECTION _____

Please indicate well location X.

ADDITIONAL INFORMATION

If more than one screen, show locations of each on sketch.