

MISSISSIPPI DEPARTMENT OF ENVIRONMENTAL QUALITY

Office of Land and Water Resources

P. O. Box 10631  
Jackson, MS 39289-0631  
WATER WELL DRILLERS LOG

COUNTY WELL LOCATED Harrison	
WELL NUMBER N-339	CODED
DATE WELL COMPLETED 8-15-02	

MSGW-15910

PERMIT NUMBER 0404
NAME OF DRILLING FIRM Lynan Well Co.
Address Huepport, Ms. 39503

NAME & MAILING ADDRESS OF LANDOWNER TEST PO Box 1770 39566-1770 Ocean Springs			
Latitude: Longitude:			
WELL LOCATION:	SEC 27	TOWNSHIP 8	RANGE 13
DISTANCE	DIRECTION	NEAREST TOWN	
OTHER LANDMARK Henderson Point			
WELL PURPOSE: Home, Irrigation, Municipal, Industrial, Fish Pond, etc.			

PUMP DATA		
PUMP TYPE (Circle One): Submersible, <u>Turbine</u> Jet Flowing Well, Other (Describe)		
POWER TYPE (Circle One): <u>Electric</u> Tractor, Diesel, Gasoline, Butane, Other (Describe) H/P <u>20</u>		
DESCRIPTION OF FORMATIONS ENCOUNTERED	FROM	TO
NA		
Just		
Completed		
Well		
RECEIVED		
MAY 01 2003		
BY: OLW		
Top of Lap Pipe or Reduction in Casing 640 FEET IF TELESKOPED OR MORE THAN ONE SCREEN: USE BACK PAGE		

WELL DATA		
Well Depth 780	Casing Diameter (In.) 10"	Casing Length (Ft.) 700
Type of Casing steel	Hole Depth 780	Depth to Static Water Level 30'
TYPE OF COMPLETION: (Circle One or More): <u>Gravel Packed</u> , <u>Underreamed</u> , <u>Telescoped</u> , Natural Development, Open Hole, Other (Describe)		
WELL GROUTED TO A DEPTH OF 500 FEET Type Grout (circle one): <u>Cement</u> , Bentonite, or Mix		

SCREEN DATA		
Diameter - Inches 6"	Length - Feet 40'	Slot Size - Inches .010
Screen Type SS wrap on rods	Depth to Bottom - Feet 780	


I certify that the well was drilled, constructed and completed in accordance with all applicable Requirements of the Mississippi Department of Environmental Quality and/or the Mississippi Department of Health regulations and state laws.

Signature of Licensed Driller and License No.  
John Ladner 0-640

Date  
8/26/02

If well telescopes please sketch and show depths.

GROUND LEVEL

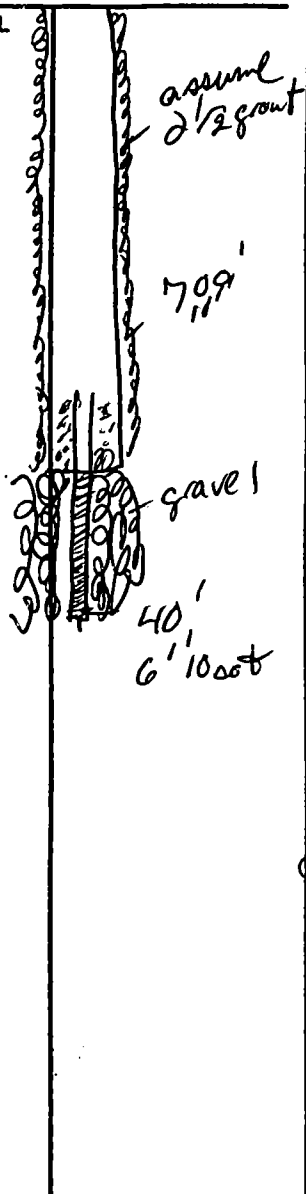


SECTION \_\_\_\_\_

Please indicate well location X.

Pump Capacity (GPM)	No. of Stages	Setting Depth	
350	4	80	FT.
PUMP TEST			
Well yielded _____ GPM with			
a drawdown of _____ ft.			
after _____ hours of pumping			

LOG DATA

TYPE OF LOG RUN (Circle One): No Log Run, Electric, Gamma Ray, Density, Sonic, Neutron, Other (Describe) \_\_\_\_\_

Name of Organization Running Log  
DEQ

GEOLOGIC DATA (Office Use Only)

Surface Elev.	Geologic Unit	Unit Thickness	Depth to Top
Subs. SWL	Date	Analysis	Aquifer Test

Driller's Remarks

The grouting of the casing was based on information provided by the owner.

If more than one screen, show location of each on sketch.