

STATE WELL REPORT

6

County: Harrison
 Permit #: NA
 Driller: Lyman Well
 Date drilling completed: 10/13/2021

**Part 1
 Driller's Log**
 Mississippi Department of Environmental Quality
 Office of Land and Water Resources
 P.O. Box 2309
 Jackson, MS 39225-2309
 (601)961-5555
 (601)961-5228 (fax)

For Office Use Only:

Well #: N 372
 Aquifer: _____
 E-Log #: _____

State Law requires that this report be prepared by the license holder responsible for the work and filed with the Department at the above address within 30 days of completion of drilling of the well or borehole.

Well Owner Information <small>(Landowner if borehole is not for a water well)</small>	Well or Borehole Location
Owner Name: <u>Gulf Coast Prestress</u>	Latitude: <u>30°20.221'N</u> Longitude: <u>89°15.383'W</u>
Mailing Address: <u>494 North Market</u> <u>St</u>	Method of Lat/Long (check one): Conventional Survey _____, <u>30 20 13</u> <u>89 15 22</u>
<u>Pasc Christian MS 39571</u>	USGS quad _____, Hand-held GPS <input checked="" type="checkbox"/> , Survey-grade GPS _____
City State Zip Code	<u>NW</u> ¼ <u>NW</u> ¼, Sec. <u>24</u> T. <u>8S</u> R. <u>13W</u>
Telephone No. <u>(228) 452-9486</u>	_____ Miles _____ of _____ (Distance) (Direction) (Nearest Town)

Well / Borehole Data

Date drilling started: 9/22/2021 Date drilling completed: 10/13/2021 Hole depth: 840 Hole diameter: 7 7/8

Location of the source of any surface water used for drilling: NA

Method of dosing and volume of Chlorine used in drilling and development: NA

Logs run (check all applicable): log run Electric Gamma Ray Density Sonic Neutron Other: _____

Name of organization running log(s): _____

Purpose of borehole (check one): Water Well Geotechnical/Geological Investigation Ground Source Heat Pump
 Seismic Survey Other (describe) _____

If drilling is not related to water well construction, skip the remainder of this block

Purpose of Well (check all applicable): Home Industrial Public Supply Irrigation Fish Culture
 Other (describe): _____

If a flowing well, method of flow regulation: Valve _____ Other (describe) _____

Static Water Level: 10 feet above or below land surface Date measured: 10/13/2021
(check one)

Method of measurement (check one) Steel tape Electric tape Air line Other (describe): _____

Well depth: 840 Well grouted to a depth of: 50 feet Type of grout (check one) Neat Cement Bentonite Mix

Casing length: 800 feet Casing diameter: 4" inches Type of casing: Steel

Screen length: 40 feet Screen diameter: 3x5 inches Type of screen: SS wrap munirack

Screen slot size: .008 inches Setting depth: From 800 feet to 840 feet

Type of completion (check all applicable) gravel packed Underreamed Open hole Natural Development

Other (describe): _____

Top of lap pipe or reduction in casing: _____ feet

If telescoped or more than one screen, describe on next page


RECEIVED
 NOV 01 2021
 BY OLWR

County: Harrison
 Permit #: NA

For Office Use Only:
 Well #: _____

The sketch below only required for water wells

If well telescopes, show depths on sketch.

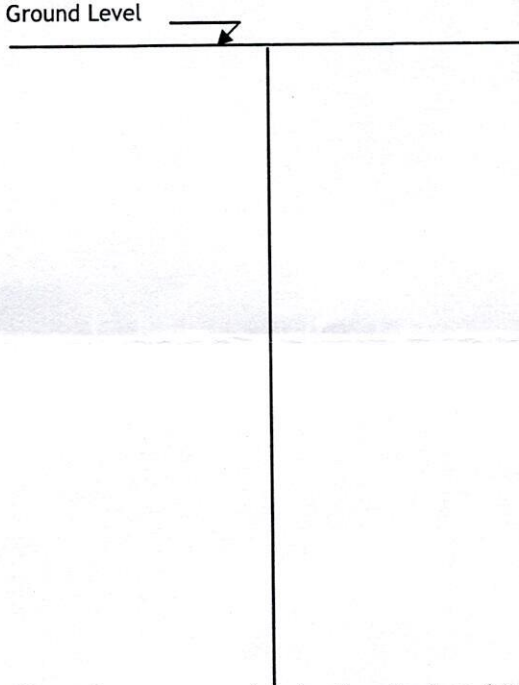

If more than one screen, show location of each on sketch

Description of formations encountered must be provided for all wells and boreholes, unless specifically exempted by regulations

Description of Formations Encountered	From (depth)	To (depth)
sand	Ground level	80
clay	80	320
sand	320	636
clay	690	790
sand	790	840

- Sketch the property layout and include the following:
- 1) the well location
 - 2) any permanent structures on the property that may aid in locating the well
 - 3) any roads, power lines, or other items that may aid in locating the property and the well
 - 4) north arrow

see map

RECEIVED
 NOV 01 2021
 BY OLWR

Landowner Name: Gulf Coast Prestress

I HEREBY CERTIFY that the well/borehole was drilled, constructed, and completed in accordance with all applicable requirements of the Mississippi Department of Environmental Quality and the Mississippi Department of Health regulations, if applicable, and state laws.

Josh Ladner 0-440 10/28/2021 [Signature]
 Print Name of Responsible Licensee and License No. Date Signature of Licensee

STATE WELL REPORT

Part 2

Pump Installer's Completion Report
 Mississippi Department of Environmental Quality
 Office of Land and Water Resources
 P.O. Box 2309
 Jackson, MS 39225-2309
 (601)961-5210
 (601) 360-0535 (fax)

For Office Use Only:

Well #: N 372
 Aquifer: _____

County: Harrison
 Permit #: N/A
 Driller: Lynon Well
 Date completed: 10/19/2021
Copy information from block on Part 1

This part of the report must be completed by a licensed water well contractor or a licensed pump installer. A copy of Part 1 of the report must be attached and both parts filed with the Department at the above address within 30 days of well completion.

Well Owner Information	Well Location
Owner Name: <u>Gulf Coast Prestress</u>	Latitude: <u>30° 20.221'</u> Longitude: <u>89° 15.363' W</u>
Mailing Address: <u>494 North Market St</u>	Method of Lat/Long (check one): Conventional Survey _____, <u>30 20 13</u> <u>89 15 22</u> USGS quad _____, Hand-held GPS <input checked="" type="checkbox"/> , Survey-grade GPS _____
<u>Pass Christian MS 39521</u>	<u>NW</u> ¼ <u>NW</u> ¼, Sec <u>29</u> T <u>8S</u> R <u>13W</u>
City State Zip Code	Miles _____ of _____ (Distance) (Direction) (Nearest Town)
Telephone No. <u>228 452-7486</u>	

Pump Type (check one)

Submersible Turbine Air Lift Centrifugal Flowing Well Jet Piston Rotary Other (describe): _____

Date Pump Installed: 10/19/2021 Rated Pump Capacity: 90 Gallons Per Minute

Is This Pump (check one): New Repaired Replacement

Power Type (check one)

Electric Diesel Gasoline Natural Gas Tractor PTO Windmill Other (describe): _____

Horse Power Rating of Motor: 5 Setting Depth: 105 feet Number of Stages: 7

Pump Test Data for Non Flowing Well

Date Well Tested: 10/22/2021 Duration of Pump Test (minimum 4 hours): _____ hours

Static Water Level (A): 10 Feet Below Land Surface Pumping Water Level (B): 31 Feet Below Land Surface

Drawdown [(B) - (A)]: 21 Feet Below Land Surface Test Pumping Rate: 75 Gallons Per Minute

Method of measurement (check one): Steel tape Electric tape Air line Other (describe): _____

Pump Test Data for Flowing Well

Measured shut in head: _____ feet.

Well yielded _____ GPM with a drawdown of _____ feet after _____ hours of pumping

Meter Installation

Meter Manufacturer: _____ Meter Serial Number: _____

Meter Model Number/Name: _____ Type of Meter: _____

Totalizer Register Unit and Multiplier Factor (AF x .001, gal x 1000, etc): _____

Installation Date: _____ Meter installed by: _____

Is This Meter (check one): New Repaired Replacement

Important: By submitting the above information you are certifying that this meter was installed to manufacturer standards. For agricultural wells, a list of approved meters is on the MDEQ website.

RECEIVED
 NOV 01 2021
 BY OLWR

I HEREBY CERTIFY that the above statements are true to the best of my knowledge.

Josh Ledner 0-640 10/28/2021

Print Name of Pump Installer and License No. (if applicable) Date Signature of Pump Installer



Ave

West St

Parker Ave

Rita St

Pass Christian RV Park

Front: Solutions

Clark Ave

GULF COAST PRESTRESS

Gulf Coast Prestress Partners, Ltd

RECEIVED
NOV 01 2011
BY OLWR