

HARRISON
 N 2003
 6-5-76

MISSISSIPPI
 BOARD OF WATER COMMISSIONERS
 416 North State Street
 Jackson, Mississippi 39201

WATER WELL DRILLERS LOG

June 5 1976 The BRYANT Well Co. HARRISON
 date well completed firm name county well located

LANDOWNER: WILLIAM GATES
Route 3 Box 763
Poss Christian, MS
 (mailing address)

WELL LOCATION:
 sec 2 T 8 R 13
 S W
1/4 miles delisle of
 (distance) (direction) (nearest town)

WELL PURPOSE: HOME
 (home, irrigation, municipal, industrial)

- WELL COMPLETION DATA:
- (1) diameter (inches) 2"
 - (2) total depth (feet) 268
 - (3) static water level (feet) 8 below top of ground.
 - (4) casing PVC, 263,
 (material) (depth)
— If telescope see back.
 (size)
 - (5) screen 5', 263'
 (length) (depth to top)
1008, PVC
 (size) (material)
 - (6) pump None
 (HP) (yield gpm)
—
 (type power)
 - (7) electric log NO
 (yes or no)
—
 (organization running log)
 - (8) how well bottom plugged metal
SAND SHARK

description of formations encountered	from	to
Red clay	0	15
White sand	15	39
White clay	39	49
Orange sand & shale	49	65
Blue clay	65	139
Orange sand	139	152
Blue clay	152	215
Orange sand	215	217
Blue clay	217	236
Orange sand	236	268


RECEIVED
 JUL - 8 1976

MISS. BD. OF WATER COMM

DRILLERS REMARKS:

If well telescopes please sketch and show depths.

GROUND LEVEL

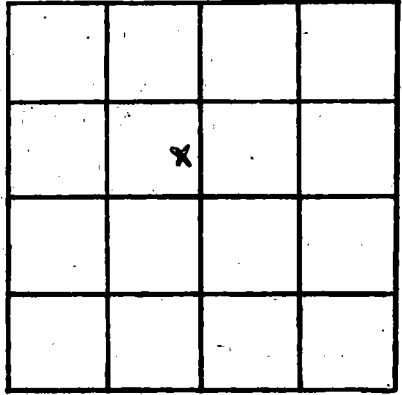

SECTION 2

Please indicate well location X.

ADDITIONAL INFORMATION

If more than one screen, show locations of each on sketch.