

Harrison
 N 2006
 9/12/76

MISSISSIPPI
 BOARD OF WATER COMMISSIONERS
 416 North State Street
 Jackson, Mississippi 39201

WATER WELL DRILLERS LOG

Sept. 12 1976 Duncan Well Drilling Harrison
 date well completed firm name county well located

LANDOWNER: <u>Alphonse Delaney, Jr.</u>	description of formations encountered	from	to
Rt. 3 Box 535	gravel + clay	0	10
Delisle, Miss.	fine sand	10	60
(mailing address)	course sand	60	80
WELL LOCATION:			
sec. <u>3</u> T. <u>28</u> N. R. <u>13</u> W.			
<u>1/4</u> miles <u>E</u> of <u>Delisle</u>			
(distance) (direction) (nearest town)			
WELL PURPOSE:			
(home, irrigation, municipal, industrial)			
WELL COMPLETION DATA:			
(1) diameter (inches) <u>2"</u>			
(2) total depth (feet) <u>80 feet</u>			
(3) static water level (feet) <u>16</u> <u>below</u> <u>above</u> top of ground.			
(4) casing <u>PVC</u> <u>70</u> (material) (depth)			
<u> </u> (size) if telescope see back.			
(5) screen <u>10'</u> <u>70</u> (length) (depth to top)			
<u>2"</u> <u>PVC</u> (size) (material)			
(6) pump <u> </u> <u> </u> (HP) (yield gpm)			
<u> </u> (type power)			
(7) electric log <u> </u> (yes or no)			
<u> </u> (organization running log)			
(8) how well bottom plugged <u>Back</u> <u>wood valve</u>			
DRILLERS REMARKS:			


RECEIVED

JAN 9 1977

MISS. BD. OF WATER COMM.

If well telescopes please sketch and show depths.

GROUND LEVEL

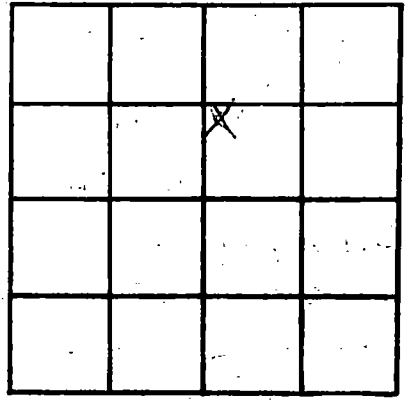

SECTION 3

Please indicate well location X.

ADDITIONAL INFORMATION

Lined area for additional information.

If more than one screen, show locations of each on sketch.