

HARRISON  
N 2007  
9-13-76

MISSISSIPPI  
 BOARD OF WATER COMMISSIONERS  
 416 North State Street  
 Jackson, Mississippi 39201

WATER WELL DRILLERS LOG

Sept. 13 1976 Duncan Well Drilling Harrison  
 date well completed firm name county well located

LANDOWNER: <u>Edward Dedaux</u>	description of formations encountered	from	to
<u>Route 2 Box 609-A</u> <u>Delisle, Miss</u> (mailing address)	<u>gravel &amp; clay</u> <u>fine sand</u> <u>concrete sand</u>	<u>0</u> <u>10</u> <u>60</u>	<u>10</u> <u>60</u> <u>80</u>
<b>WELL LOCATION:</b> sec <u>3</u> T. <u>30</u> R. <u>13</u> <u>1/4</u> miles <u>E</u> of <u>Delisle</u> (distance) (direction) (nearest town)			
<b>WELL PURPOSE:</b> (home, irrigation, municipal, industrial)			
<b>WELL COMPLETION DATA:</b>			
(1) diameter (inches) <u>2"</u>			
(2) total depth (feet) <u>80 feet</u>			
(3) static water level (feet) <u>16</u> <sup>below</sup> above top of ground.			
(4) casing <u>pvc</u> , <u>70</u> (material) (depth)			
_____ If telescope see back. (size)			
(5) screen <u>10'</u> , <u>70'</u> (length) (depth to top)			
<u>2"</u> , <u>pvc</u> (size) (material)			
(6) pump _____ (HP) (yield gpm)			
_____ (type power)			
(7) electric log _____ (yes or no)			
_____ (organization running log)			
(8) how well bottom plugged <u>Back</u> <u>wash screen</u>			
DRILLERS REMARKS:			


RECEIVED

JAN 3 1977

MISS. BD. OF WATER COMMISSIONERS

If well telescopes please sketch and show depths.

GROUND LEVEL

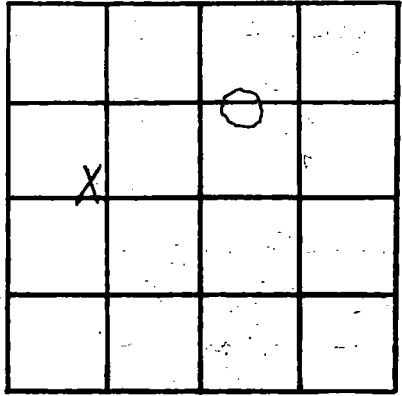

SECTION 3

Please indicate well location X.

ADDITIONAL INFORMATION

If more than one screen, show locations of each on sketch.