

HARRISON
 N 2008
 9/17/76

MISSISSIPPI
 BOARD OF WATER COMMISSIONERS
 416 North State Street
 Jackson, Mississippi 39201
 WATER WELL DRILLERS LOG

Sept. 17 1976 Duncon Well Drilling Harrison
 date well completed firm name county well located

LANDOWNER: Mitchell Dedeaux
 Route 3 Box 556
 Pass Christian, Miss
 (mailing address)

description of formations encountered	from	to
gravel + clay	0	12
fine sand	10	60
coarser sand	60	80

WELL LOCATION:
 sec 3 T 38 N R 13 E
 1/4 miles E of Delisle
 (distance) (direction) (nearest town)

WELL PURPOSE: home
 (home, irrigation, municipal, industrial)

- WELL COMPLETION DATA:
- (1) diameter (inches) 2"
 - (2) total depth (feet) 80 feet
 - (3) static water level (feet) 16 below above top of ground.
 - (4) casing PVC, 70 (material) (depth)
 - (size) If telescope see back.
 - (5) screen 10" 70 (length) (depth to top)
 - 2" PVC (size) (material)
 - (6) pump (HP) (yield gpm)
 - (type power)
 - (7) electric log (yes or no)
 - (organization running log)
 - (8) how well bottom plugged Back Wash valve

RECEIVED


JAN 8 1977

DRILLERS REMARKS:

MISS. BD. OF WATER COMM

If well telescopes please sketch and show depths.

GROUND LEVEL

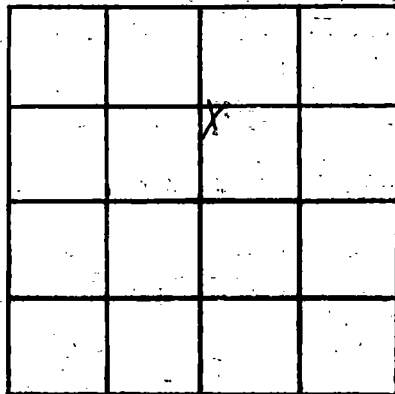

SECTION 3

Please indicate well location X.

ADDITIONAL INFORMATION

If more than one screen, show locations of each on sketch.