

Harrison  
 N 2010  
 3/9/77

MISSISSIPPI  
 BOARD OF WATER COMMISSIONERS  
 416 North State Street  
 Jackson, Mississippi 39201

WATER WELL DRILLERS LOG

March 9 1977 McHill well works Harrison  
 date well completed firm name county well located


LANDOWNER: <u>DeLisle Fire Dept</u>	description of formations encountered	from	to
<u>DeLisle Mo.</u> <u>San Hel!</u> (mailing address)	<u>sand</u>	<u>0</u>	<u>60</u>
WELL LOCATION:	<u>slush</u>	<u>60</u>	<u>120</u>
sec. <u>8</u> T. <u>4</u> N. R. <u>13</u> E.	<u>B. clay</u>	<u>120</u>	<u>171</u>
<u>1/2</u> miles <u>S</u> of <u>Jasper</u>	<u>S. sand</u>	<u>171</u>	<u>231</u>
WELL PURPOSE: <u>Industrial</u>	<u>slush</u>	<u>231</u>	<u>273</u>
WELL COMPLETION DATA:	<u>B. clay</u>	<u>273</u>	<u>385</u>
(1) diameter (inches) <u>5 1/2</u> feet	<u>S. sand</u>	<u>385</u>	<u>410</u>
(2) total depth (feet) <u>210</u>	<u>B. clay</u>	<u>410</u>	<u>499</u>
(3) static water level (feet) <u>51.5</u> below top of ground	<u>A. sand</u>	<u>499</u>	<u>547</u>
(4) casing <u>gal.</u> (material) <u>527</u> (depth)			
_____ if telescope see back. (size)			
(5) screen <u>20'</u> (length) _____ (depth to top)			
<u>2"</u> (size) <u>5.5</u> (material)			
(6) pump <u>1</u> (HP) <u>16</u> (yield/gpm)			
<u>electric</u> (type power)			
(7) electric log <u>no</u> (yes or no)			
_____ (organization running log)			
(8) how well bottom plugged <u>and</u>			
<u>shark</u>			
DRILLERS REMARKS:			

RECEIVED  
 JAN 18 1978

MISS. Bd. OF WATER COMM

If well telescopes please sketch and show depths.

GROUND LEVEL

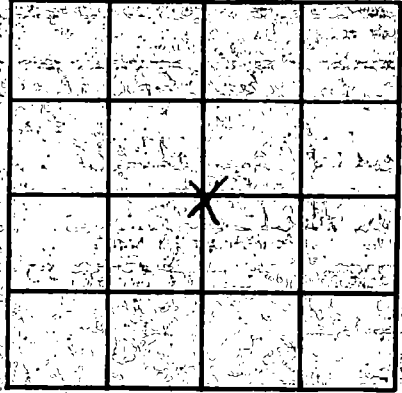

SECTION 8

Please indicate well location X.

ADDITIONAL INFORMATION

If more than one screen, show locations of each on sketch.