

HARRISON
 N 2011
 6-3-77

MISSISSIPPI
 BOARD OF WATER COMMISSIONERS
 416 North State Street
 Jackson, Mississippi 39201

WATER WELL DRILLERS LOG

June 3 1977 *Harrison Well Drilling Harrison*
 date well completed firm name county well located


LANDOWNER:	description of formations encountered	from	to
Consuel Dedeaux	Clay	0	20
De Lisle, MS (mailing address)	sand & gravel	20	120
WELL LOCATION:	Blue clay	120	180
sec. 8 T 80 N 13 R 1 E 0 miles 0 of DeLisle (distance) (direction) (nearest town)	fine sand	180	230
WELL PURPOSE: (home, irrigation, municipal, industrial)	Blue clay	230	460
WELL COMPLETION DATA:	Course shud.	460	504
(1) diameter (inches) 2"			
(2) total depth (feet) 504			
(3) static water level (feet) 1 ^{below} top of ground			
(4) casing PVC 494 (material) (depth)			
If telescope see back.			
(5) screen 10" 494 (length) (depth to top)			
2" Stamped (size) (material)			
(6) pump (HP) (yield gpm)			
(type power)			
(7) electric log (yes or no)			
(organization running log)			
(8) how well bottom plugged sand shale			
DRILLERS REMARKS: No pump install			

RECEIVED
 JUN 24 1977

MISS. BD. OF WATER COMM

If well telescopes please sketch and show depths.

GROUND LEVEL

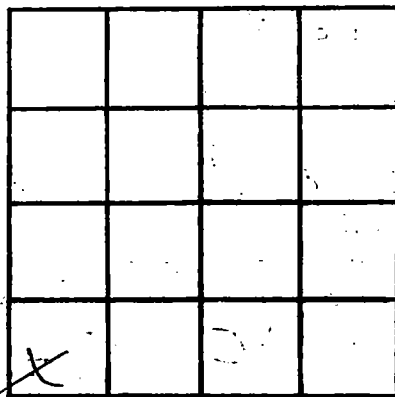

SECTION 8

Please indicate well location X.

ADDITIONAL INFORMATION

If more than one screen, show locations of each on sketch.