

HARRISON
N 2012
6-3-77

MISSISSIPPI
 BOARD OF WATER COMMISSIONERS
 416 North State Street
 Jackson, Mississippi 39201

WATER WELL DRILLERS LOG

June 3 1977 Duncan Well Drilling Harrison
 date well completed firm name county well located

LANDOWNER:	description of formations encountered	from	to
<u>Louis Cook</u>			
<u>P.O. Box 20 Pass Christian Ms. (mailing address)</u>	<u>CLAY SAND + gravel</u>	<u>0 20</u>	<u>20 100</u>
WELL LOCATION:			
sec. <u>8</u> T. <u>8</u> N. S. R. <u>B</u> E. W. <u>W</u> <u>Delisle</u> (distance) (direction) (nearest town)			
WELL PURPOSE: <u>Home</u> (home, irrigation, municipal, industrial)			
WELL COMPLETION DATA:			
(1) diameter (inches) <u>2"</u>			
(2) total depth (feet) <u>100</u>			
(3) static water level (feet) <u>10</u> <u>below</u> above top of ground.			
(4) casing <u>PVC</u> , <u>+00 90</u> (material) (depth)			
_____ If telescope see back. (size)			
(5) screen <u>10'</u> <u>90</u> (length) (depth to top)			
<u>2"</u> <u>pvc sch 40</u> (size) (material)			
(6) pump _____ (HP) (yield gpm)			
_____ (type power)			
(7) electric log _____ (yes or no)			
_____ (organization running log)			
(8) how well bottom plugged <u>hard</u> <u>shale</u>			
DRILLERS REMARKS:			
<u>No pump install</u>			


RECEIVED

JUN 24 1977

MISS. Bd. OF WATER COMMISSIONERS

If well telescopes please sketch and show depths.

GROUND LEVEL

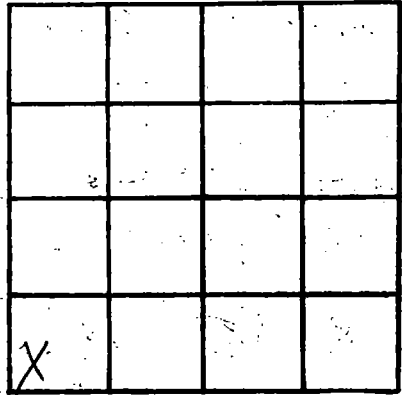

SECTION 8

Please indicate well location X.

ADDITIONAL INFORMATION

If more than one screen, show locations of each on sketch.