

HARRISON
N 2013
6-21-77

MISSISSIPPI
BOARD OF WATER COMMISSIONERS
 416 North State Street
 Jackson, Mississippi 39201

WATER WELL DRILLERS LOG


June 21 1977 Duncan Well Drilling Harrison
 date well completed firm name county well located

LANDOWNER:	description of formations encountered	from	to
<u>Robert Jones</u> <u>Rt. 3 Box 703</u> <u>Pass Christian Ms</u> (mailing address)			
	<u>sand & gravel</u>	<u>20</u>	<u>125</u>
	<u>Blue clay</u>	<u>125</u>	<u>180</u>
	<u>fine sand</u>	<u>180</u>	<u>250</u>
	<u>Blue clay</u>	<u>250</u>	<u>290</u>
	<u>fine sand</u>	<u>290</u>	<u>310</u>
	<u>Course sand</u>	<u>310</u>	<u>357</u>
WELL LOCATION: sec. <u>8</u> T. <u>8N</u> R. <u>13E</u> <u>Delisle</u> (distance) (direction) (nearest town)			
WELL PURPOSE: <u>Home</u> (home, irrigation, municipal, industrial)			
WELL COMPLETION DATA:			
(1) diameter (inches) <u>2"</u>			
(2) total depth (feet) <u>357</u>			
(3) static water level (feet) <u>4</u> <u>below</u> above top of ground.			
(4) casing <u>PVC</u> <u>347</u> (material) (depth)			
(size) <u>10'</u> <u>347</u> If telescope see back. (length) (depth to top)			
(5) screen <u>2"</u> <u>pvc sch. 40</u> (size) (material)			
(6) pump _____ (HP) _____ (yield gpm) (type power)			
(7) electric log _____ (yes or no) (organization running log)			
(8) how well bottom plugged <u>sand</u> <u>shark</u>			
DRILLERS REMARKS: <u>No pump install</u>			

RECEIVED
 JUN 24 1977

If well telescopes please sketch and show depths.

GROUND LEVEL

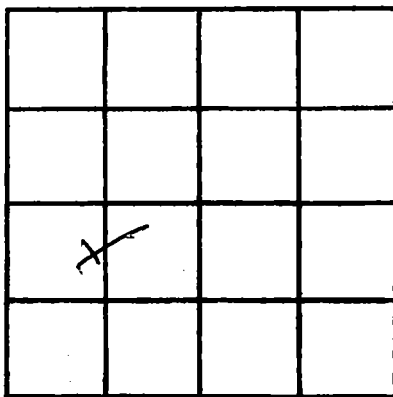

SECTION 8

Please indicate well location X.

ADDITIONAL INFORMATION

If more than one screen, show locations of each on sketch.