

Harrison
 N 2016
 11/7/77

MISSISSIPPI
 BOARD OF WATER COMMISSIONERS
 416 North State Street
 Jackson, Mississippi 39201

WATER WELL DRILLERS LOG


Nov. 7 1977 Duncan Well Drilling Harrison
 date well completed firm name county well located

LANDOWNER:	description of formations encountered	from	to
Dana Hawthorne	Top Sand	0	165
Rt. 2 Box 550	Blue clay	165	180
(mailing address)	fine sand	180	220
WELL LOCATION:	Coarse sand	220	250
sec 2 T 8 N R 13 E 1/4 miles E of Delisle (distance) (direction) (nearest town)			
WELL PURPOSE: <u>home</u> (home, irrigation, municipal, industrial)			
WELL COMPLETION DATA:			
(1) diameter (inches) <u>2"</u>			
(2) total depth (feet) <u>250</u>			
(3) static water level (feet) <u>2'</u> <u>below</u> top of ground			
(4) casing <u>PVC</u> <u>240</u> (material) (depth)			
_____ If telescope see back. (size)			
(5) screen <u>10'</u> <u>240</u> (length) (depth to top)			
<u>2"</u> <u>PVC</u> <u>24.40</u> (size) (material)			
(6) pump <u>1</u> <u>14</u> (HP) (yield gpm)			
<u>electric</u> (type power)			
(7) electric log _____ (yes or no)			
_____ (organization running log)			
(8) how well bottom plugged <u>Sand</u> <u>Shark</u>			
DRILLERS REMARKS:			

RECEIVED
 JAN 25 1978
 MISS. BD. OF WATER COMM

If well telescopes please sketch and show depths.

GROUND LEVEL

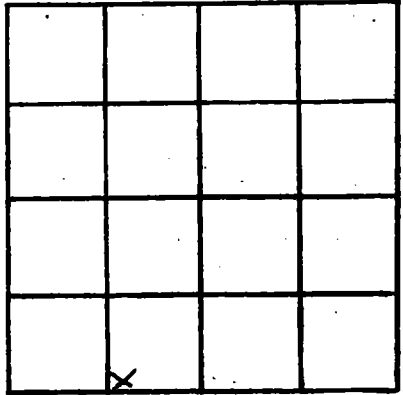

SECTION 39

Please indicate well location X.

ADDITIONAL INFORMATION

If more than one screen, show locations of each on sketch.