

Harrison
 N 2017
 12/16/77

MISSISSIPPI
 BOARD OF WATER COMMISSIONERS
 416 North State Street
 Jackson, Mississippi 39201

WATER WELL DRILLERS LOG

12-16-1977 Wood Well Dlg. Harrison
 date well completed firm name county well located

LANDOWNER H.H. Sassinre
115 Fort Henry ave.
Pass Christian miss
 (mailing address)

WELL LOCATION:
 sec. 27 T. 8 N. R. 13 E.
2 miles W of Pass Christian
 (distance) (direction) (nearest town)

WELL PURPOSE: Home
 (home, irrigation, municipal, industrial)

WELL COMPLETION DATA:
 (1) diameter (inches) 2"
 (2) total depth (feet) 482
 (3) static water level (feet) 3 ^{below} above top of ground.
 (4) casing PVC, 467,
 (material) (depth)
 (size) If telescope see back.
 (5) screen 15,
 (length) (depth to top)
2", PVC,
 (size) (material)
 (6) pump runner,
 (HP) (yield gpm)
 (type power)
 (7) electric log NO
 (yes or no)
N/A
 (organization running log)
 (8) how well bottom plugged BWW

description of formations encountered	from	to
clay	0	5
sd	5	15
clay	15	35
sd	35	52
clay	52	110
sd	110	136
clay	136	423
sd-course	422	482


RECEIVED
 JAN 30 1978

MISS. BD. OF WATER COMM

DRILLERS REMARKS:

If well telescopes please sketch and show depths.

GROUND LEVEL

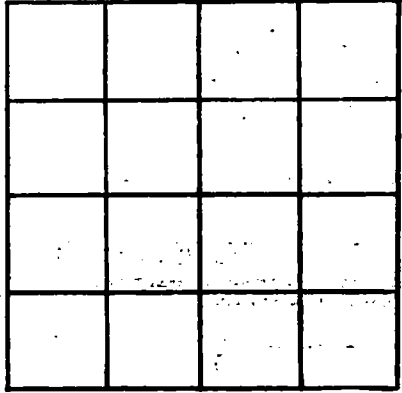

SECTION 27

Please indicate well location X.

ADDITIONAL INFORMATION

If more than one screen, show locations of each on sketch.