

HARRISON

N 2018

6-22-78

MISSISSIPPI BOARD OF WATER COMMISSIONERS 416 North State Street Jackson, Mississippi 39201

WATER WELL DRILLERS LOG

6/22/78 19 Coated Drilling Harrison date/well completed firm name county well located

LANDOWNER

Carl Leggett

description of formations encountered

from to

Morgan Ave

Top soil

1 3

pass Christian, Miss (mailing address)

Red Clay

3 15

Coarse white sand

15 60

Sugar Sand

60 210

Soft Blue Clay

210 315

hard Blue Clay

315 510

fine water sand

510 575

Coarse water sand

575 650

WELL LOCATION:

sec 6 T 8 N R 13 E W

0.5 miles Daisie, Miss? (distance) (direction) (nearest town)

WELL PURPOSE:

home (home, irrigation, municipal, industrial)

WELL COMPLETION DATA:

(1) diameter (inches) 2"

(2) total depth (feet) 550'

(3) static water level (feet) 0 below top of ground

(4) casing PVC 540' (material) (depth)

(5) screen 10' 540' (length) (depth to top)

2" PVC (size) (material)

(6) pump One 15 (HP) (yield gpm)

Ele (type power)

(7) electric log no (yes or no)

(organization running log)

(8) how well bottom plugged

DRILLERS REMARKS:


Miss. Board of Water Comm

FEB 8 1979

RECEIVED

If well telescopes please sketch and show depths.

GROUND LEVEL

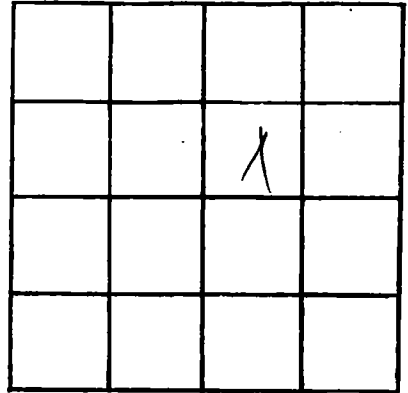

SECTION \_\_\_\_\_

Please indicate well location X.

ADDITIONAL INFORMATION

If more than one screen,  
show locations of each on sketch.