

HARRISON
N 2022
11-13-78

**MISSISSIPPI
BOARD OF WATER COMMISSIONERS**
416 North State Street
Jackson, Mississippi 39201

WATER WELL DRILLERS LOG

11-13-1978 Word Well Dlg Harrison
 date well completed firm name county well located

LANDOWNER: R. M. Edowell
Menge ave
Pass Christian, Miss
 (mailing address)

WELL LOCATION:
 sec. 25 T. 8 N. R. 13 E.
10? miles N of P.C.
 (distance) (direction) (nearest town)

WELL PURPOSE: Home
 (home, irrigation, municipal, industrial)

WELL COMPLETION DATA:

(1) diameter (inches) 2"

(2) total depth (feet) 505

(3) static water level (feet) 55 ^{below} top of ground

(4) casing PVC, 495.
 (material) (depth)
 (size) if telescope see back.

(5) screen 10' (length) (depth to top)
2" (size) PVC (material)

(6) pump owner
 (HP) (yield gpm)
 (type power)

(7) electric log NO
 (yes or no)
NA
 (organization running log)

(8) how well bottom plugged BWV


description of formations encountered	from	to
top soil - clay	0	20
orange sd	20	57
grey clay	57	98
sd clay	98	127
sd	127	156
clay - silt	156	476
coarse sd	476	505

DRILLERS REMARKS: Did not bottom out on sd.

RECEIVED
 DEC 21 1978
 MISS. BO. OF WATER COMM.

If well telescopes please sketch and show depths.

GROUND LEVEL

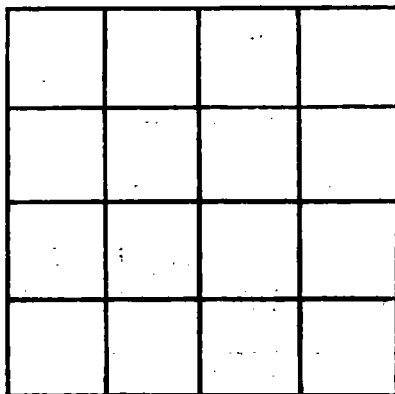

SECTION 25

Please indicate well location X.

ADDITIONAL INFORMATION

If more than one screen, show locations of each on sketch.