

MISSISSIPPI  
 BOARD OF WATER COMMISSIONERS  
 416 North State Street  
 Jackson, Mississippi 39201

WATER WELL DRILLERS LOG

HARRISON  
 N  
 2028  
 11-3-79

Harrison

11-3 1979 date well completed      firm name      county well located

LANDOWNER: John Koerner  
 436 1st AVE. JR.

description of formations encountered	from	to
Sand	0	38
Slush	38	90
C. Sand	90	130
Clay	130	172
Sand	172	223
Clay	223	269
Slush	269	280
Clay	280	296
C Sand	296	350

P.C. ma.  
 (mailing address)

WELL LOCATION:  
 sec. 22 T 8 N R 13 E  
 1 miles E of Mendenhall Pt.  
 (distance) (direction) (nearest town)

WELL PURPOSE:  
 (Home, Irrigation, municipal, Industrial)

- WELL COMPLETION DATA:
- (1) diameter (inches) 2"
  - (2) total depth (feet) 350
  - (3) static water level (feet) 1' <sup>below</sup> <sub>above</sub> top of ground.
  - (4) casing PVC, 340  
 (material) (depth)
  - if telescope see back.  
 (size)
  - (5) screen 10', plastic  
 (length) (depth to top)  
2" (size) (material)
  - (6) pump 1, 12  
 (HP) (yield gpm)  
electric  
 (type power)
  - (7) electric log no  
 (yes or no)

(organization running log)

(8) how well bottom plugged bank  
short


DRILLERS REMARKS:

DEPT. OF NATURAL RESOURCE  
 BUREAU OF LAND & WATER RESOURCE

MAY 2 1980  
 RECEIVED

If well telescopes please sketch and show depths.

GROUND LEVEL

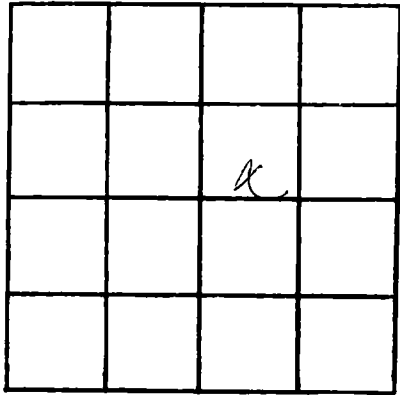

SECTION 22

Please indicate well location X.

ADDITIONAL INFORMATION

Lined area for additional information.

If more than one screen, show locations of each on sketch.