

McGILL WELL WORKS, INC.  
 RT 1 BOX 322-D  
 GULFPORT, MS 39501

MISSISSIPPI  
 BOARD OF WATER COMMISSIONERS  
 416 North State Street  
 Jackson, Mississippi 39201

WATER WELL DRILLERS LOG

HARRISON  
 N  
 2030  
 11-3-79

11-3-1979 date well completed  
 HARRISON firm name  
 county well located

LANDOWNER: Louis Kerner  
 Henderson Pt.  
 437 2<sup>nd</sup> Ave.  
 P.C. Mo.  
 (mailing address)

description of formations encountered	from	to
Sand	0	40
Slush	40	87
C. Sand	87	126
Clay	126	162
Sand	162	194
Clay	194	218
Slush	218	263
Clay	263	294
C. Sand	294	350

WELL LOCATION:  
 sec 22 T 8 N R 13 E  
 1 miles E of Makine Point  
 (distance) (direction) (nearest town)

WELL PURPOSE:  
 (Home, Irrigation, municipal, industrial)

WELL COMPLETION DATA:

(1) diameter (inches) 2"

(2) total depth (feet) 350

(3) static water level (feet) 1' below top of ground

(4) casing PVC 340 (material) (depth)

(size) if telescope see back.

(5) screen 10' (length) (depth to top)  
 2" (size) plastic (material)

(6) pump 1 (HP) 12 (yield gpm)  
 electric (type power)

(7) electric log no (yes or no)

(organization running log)

(8) how well bottom plugged back with valve


DEPT. OF NATURAL RESOURCES  
 BUREAU OF LAND & WATER RESOURCES

MAY 2 1980  
 RECEIVED

DRILLERS REMARKS:

If well telescopes please sketch and show depths.

GROUND LEVEL

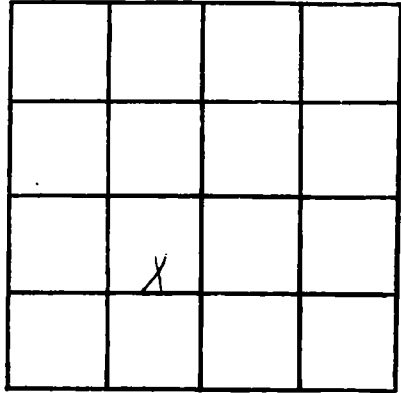

SECTION 22

Please indicate well location X.

ADDITIONAL INFORMATION

Lined area for additional information.

If more than one screen, show locations of each on sketch.