

MISSISSIPPI DEPARTMENT OF NATURAL RESOURCES

Bureau of Land and Water Resources

Southport Mall

P.O. Box 10631

Jackson, Mississippi 39209

WATER WELL DRILLERS LOG

HARRISON  
N 2032  
4/27/81

April 27 1981 Duncan Well Drilling, Throspen  
date well completed firm name county well located

LANDOWNER: Grey Labst  
500 West Airline  
La Place, La. 70068  
(mailing address)

description of formations encountered	from	to
<u>sand</u>	<u>0</u>	<u>20</u>
<u>clay</u>	<u>20</u>	<u>100</u>
<u>Blue Clay</u>	<u>100</u>	<u>180</u>
<u>fine sand</u>	<u>180</u>	<u>210</u>
<u>Blue Clay</u>	<u>210</u>	<u>260</u>
<u>fine sand</u>	<u>260</u>	<u>280</u>
<u>coarse sand</u>	<u>280</u>	<u>315</u>

WELL LOCATION:  
sec. 26 T. 8 N. R. 13 E.  
2 miles W. of Law Christman  
(distance) (direction) (nearest town)

WELL PURPOSE: Home  
(home, irrigation, municipal, industrial)

WELL COMPLETION DATA:

- (1) diameter (inches) 2"
- (2) total depth (feet) 315 ft.
- (3) static water level (feet) 10' below top of ground.
- (4) casing PVC (material) 305' (depth)
- (5) screen 10' (length) 305' (depth to top)
- (6) pump 2 (HP) 20 (yield gpm)  
electric (type power)
- (7) electric log (yes or no) \_\_\_\_\_


(organization running log) \_\_\_\_\_  
(8) how well bottom plugged Sand  
Shark

DRILLERS REMARKS: \_\_\_\_\_

MISSISSIPPI DEPARTMENT OF NATURAL RESOURCES  
BUREAU OF LAND & WATER RESOURCES  
MAY 18 1981  
**RECEIVED**

If well telescopes please sketch and show depths.

GROUND LEVEL

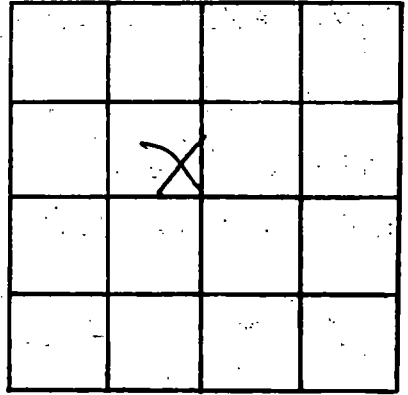

SECTION 26

Please indicate well location X.

ADDITIONAL INFORMATION

If more than one screen,  
show locations of each on sketch.