

HARRISON
N 2033
7-17-81

MISSISSIPPI
BOARD OF WATER COMMISSIONERS
 416 North State Street
 Jackson, Mississippi 39201

WATER WELL DRILLERS LOG
BRADEN PUMP AND WELL SERVICE, INC.
 ROUTE 1, BOX 489
 SAUCIER, MS 39574
HARRISON
 county well located

7-17
 date well completed

LANDOWNER:
NORMAN BRYANT
Rt 2 Box 246
39571
PASS CHRISTIAN, MS
 (mailing address)

description of formations encountered	from	to
CLAY	0	108
SAND	108	113
CLAY	113	155
SAND	155	180
CLAY	180	200

WELL LOCATION:
 sec **24** T **8** N R **13** E
4 miles **NW** of **PASS CHRISTIAN**
 (distance) (direction) (nearest town)

WELL PURPOSE: home
 (home, irrigation, municipal, industrial)

- WELL COMPLETION DATA:**
- (1) diameter (inches) 2"
 - (2) total depth (feet) 200
 - (3) static water level (feet) 75 below top of ground.
 - (4) casing PVC (material), total (depth)
2" (size) if telescope see back.
 - (5) screen 10 (length), 170 (depth to top)
2" (size), AC underbar (material)
 - (6) pump 1 (HP), 6 (yield gpm)
230 (type power)
 - (7) electric log no (yes or no)
 (organization running log)
 - (8) how well bottom plugged:
2" SAND SHARK

DRILLERS REMARKS:
20' tall PIPE


DEPT. OF NATURAL RESOURCES
 BUREAU OF LAND & WATER RESOURCES
 25 1981

RECEIVED

DEPT. OF NATURAL RESOURCES
 BUREAU OF LAND & WATER RESOURCES
 AUG 25 1981
RECEIVED
 AUG 1981
 2122 2324 2526 2728 2930 31

If well telescopes please sketch and show depths.

GROUND LEVEL

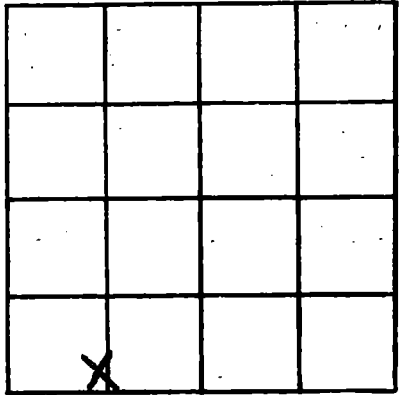

SECTION 24

Please indicate well location X.

ADDITIONAL INFORMATION

If more than one screen, show locations of each on sketch.