

MISSISSIPPI DEPARTMENT OF NATURAL RESOURCES

Bureau of Land and Water Resources

Southport Mall

P.O. Box 10631

Jackson, Mississippi 39209

WATER WELL DRILLERS LOG

**HARRISON**  
**N 2034**  
**8-17-81**

**8-17-81** 19 **Syman Well Co.** **Harrison**  
 date well completed firm name county well located

LANDOWNER: **Col. Toland**  
**P.O. Box 334**  
**Pass Christian MS**  
 (mailing address)

description of formations encountered	from	to
Top Soil	0	4
white sand & gravel	6	50
blue clay	50	420
sandy clay	420	450
blue clay	450	630
sand & gravel	630	700

WELL LOCATION:  
 sec. **25** T **8** N R **13** E  
 in **Pass Christian** miles (distance) of (direction) (nearest town)

WELL PURPOSE: **home**  
 (home, irrigation, municipal, industrial)

WELL COMPLETION DATA:

(1) diameter (inches) **4x2**

(2) total depth (feet) **100'**

(3) static water level (feet) **12** below above top of ground.

(4) casing **PVC**, **690'**  
 (material) (depth)  
**4x2** If telescope see back.  
 (size)

(5) screen **10'**, **690'**  
 (length) (depth to top)  
**2"**, **PVC**  
 (size) (material)

(6) pump **1**, **25**  
 (HP) (yield gpm)  
**electric**  
 (type power)

(7) electric log **No**  
 (yes or no)  
**No**  
 (organization running log)

(8) how well bottom plugged **sand seal**



DRILLERS REMARKS:

DEPT. OF NATURAL RESOURCES  
 BUREAU OF LAND & WATER RESOURCES

OCT 20 1981

RECEIVED

If well telescopes please sketch and show depths.

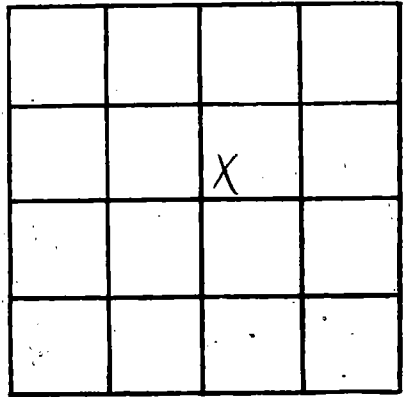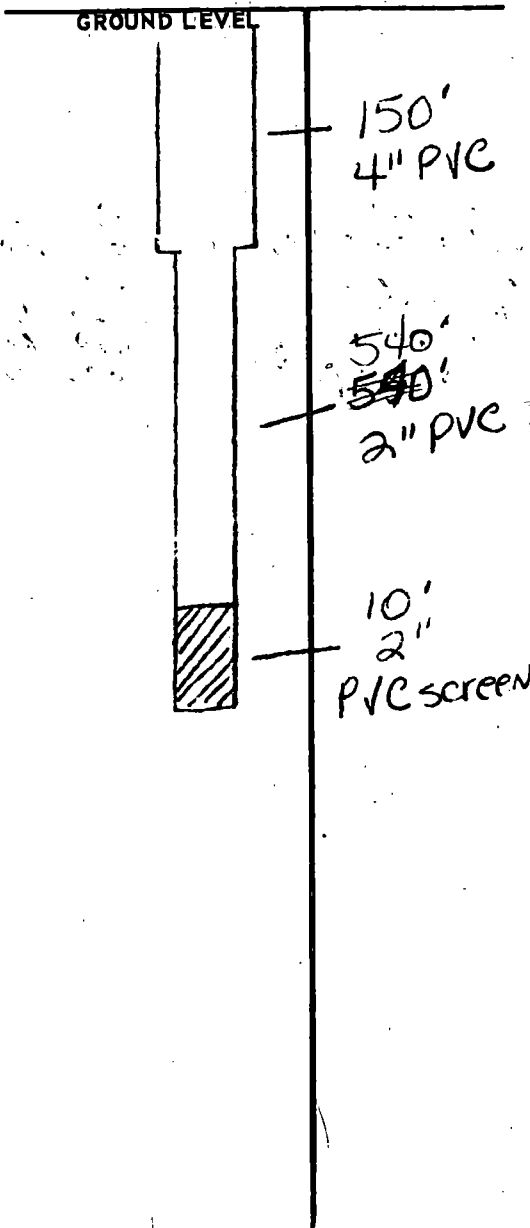

SECTION 25

Please indicate well location X.

ADDITIONAL INFORMATION

Lined area for additional information.

If more than one screen, show locations of each on sketch.