

MISSISSIPPI DEPARTMENT OF NATURAL RESOURCES
Bureau of Land and Water Resources
 Southport Mall
 P.O. Box 10631
 Jackson, Mississippi 39209
WATER WELL DRILLERS LOG

Harrison
N
2035

Jan. 26 1982 Duncan Well Drilling Harrison
 date well completed firm name county well located

LANDOWNER: E. J. Bondreaux
104 Beechwood Dr.
Pass Christian, Ms.
 (mailing address)

description of formations encountered	depth	
	from	to
<u>Blue Mud</u>	<u>0</u>	<u>21</u>
<u>Sand + Mud</u>	<u>21</u>	<u>63</u>
<u>Fine Sand</u>	<u>63</u>	<u>84</u>
<u>Coarse Sand</u>	<u>84</u>	<u>100</u>

WELL LOCATION:
 sec. 14 T. 8 N. R. 13 E.
10 miles OS of Pass Christian
 (distance) (direction) (nearest town)

WELL PURPOSE: Home
 (home, irrigation, municipal, industrial)

- WELL COMPLETION DATA:
- diameter (inches) 2"
 - total depth (feet) 100'
 - static water level (feet) 20' below above top of ground.
 - casing PVC, 90'
 (material) (depth)
1 1/2" if telescope see back.
 (size)
 - screen 10', 90'
 (length) (depth to top)
2", PVC
 (size) (material)
 - pump _____ (HP) _____ (yield gpm)
 (type power)
 - electric log _____ (yes or no)
 (organization running log)
 - how well bottom plugged sand
shark

DRILLERS REMARKS: No pump


DEPT. OF NATURAL RESOURCES
 BUREAU OF LAND & WATER RESOURCES

FEB 11 1982

RECEIVED

If well telescopes please sketch and show depths.

GROUND LEVEL

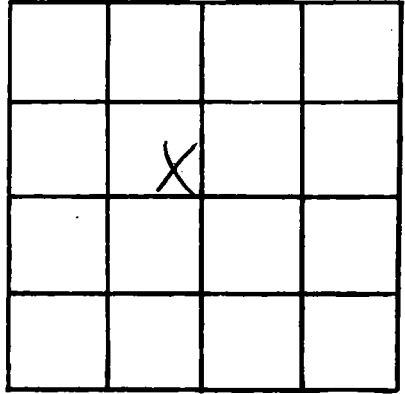

SECTION 14

Please indicate well location X.

ADDITIONAL INFORMATION

If more than one screen, show locations of each on sketch.