

MISSISSIPPI DEPARTMENT OF NATURAL RESOURCES

Bureau of Land and Water Resources

Southport Mall

P.O. Box 10631

Jackson, Mississippi 39209

COASTAL DRILLING SERVICE DRILLERS LOG

ROUTE 1 BOX 618

BILOXI, MISS 39532 name

county well located

Harrison  
N  
2036

2/1/82  
date well completed

Harrison  
county well located

LAND OWNER: Walter O'Neal  
Glad Ann  
John Christian (mailing address)

description of formations encountered	from	to
top soil	1	3
red clay	3	20
gray sand	20	35
blue sand	35	90
gray sand	90	210
50% blue clay	210	315
fine water sand	315	325
hard blue clay	325	550
fine water sand	550	630
good water sand	630	660

WELL LOCATION:  
sec. 11 T. 8 N. R. 13 E.  
10 S. W.  
Patise of  
(distance) (direction) (nearest town)

WELL PURPOSE: home  
(home, irrigation, municipal, industrial)

WELL COMPLETION DATA:

(1) diameter (inches) 2"

(2) total depth (feet) 660'

(3) static water level (feet) 10' below above top of ground

(4) casing pk 650'  
(material) (depth)  
(size) If telescope see back.

(5) screen 10' 650'  
(length) (depth to top)  
2" pk  
(size) (material)

(6) pump 1/2 15  
(HP) (yield gpm)  
Elle  
(type power)

(7) electric log no  
(yes or no)

(organization running log)

DEPT. OF NATURAL RESOURCES  
BUREAU OF LAND & WATER RESOURCES


(8) (how well) bottom plugged  
Shed with yellow  
Sand  
DRILLERS REMARKS:

MAR - 2 1982

RECEIVED

If well telescopes please sketch and show depths.

GROUND LEVEL

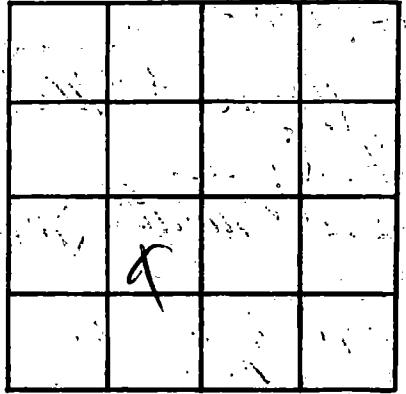

SECTION \_\_\_\_\_

Please indicate well location X.

**ADDITIONAL INFORMATION**

If more than one screen, show locations of each on sketch.