

MISSISSIPPI DEPARTMENT OF NATURAL RESOURCES

Bureau of Land and Water Resources

Southport Mall

P.O. Box 10631

Jackson, Mississippi 39209

WATER WELL DRILLERS LOG

<u>Harrison</u>
<u>N</u>
<u>2037</u>

5/20 1982 Rayman Well Co. Harrison Cty.  
 date well completed firm name county well located

LANDOWNER: Murray Keel  
Rt. 3, Box 110  
Pass Christian Ms  
 (mailing address) 39671

description of formations encountered	from	to
<u>Whited Sand</u>	<u>0</u>	<u>20</u>
<u>Red sand</u>	<u>20</u>	<u>80</u>

WELL LOCATION:  
 sec. 2 T. 8 N. R. 13 E.  
6 miles north of Pass Chris  
 (distance) (direction) (nearest town)

WELL PURPOSE: HOME  
 (home, irrigation, municipal, industrial)

- WELL COMPLETION DATA:
- (1) diameter (Inches) 4"
  - (2) total depth (feet) 80'
  - (3) static water level (feet) -6" <sup>below</sup> <sub>above</sub> top of ground.
  - (4) casing PVC 60'  
 (material) (depth)  
4"  
 (size) if telescope see back.
  - (5) screen 20' 80'  
 (length) (depth to top)  
4" PVC  
 (size) (material)
  - (6) pump NA 150  
 (HP) (yield gpm)  
NA  
 (type-power)
  - (7) electric log NO  
 (yes or no)  
NO  
 (organization running log)
  - (8) how well bottom plugged Sand  
Shark

DEPT. OF NATURAL RESOURCES  
 BUREAU OF LAND & WATER RESOURCES


JUL 14 1982

RECEIVED

DRILLERS REMARKS:

If well telescopes please sketch and show depths.

GROUND LEVEL

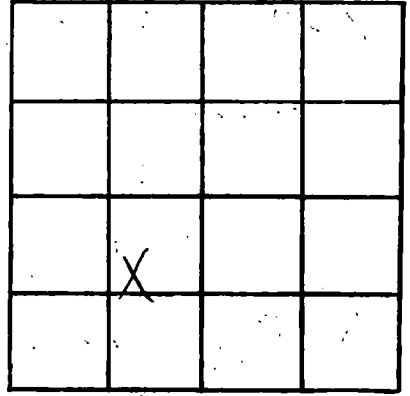

SECTION 2

Please indicate well location X.

**ADDITIONAL INFORMATION**

---

---

If more than one screen, show locations of each on sketch.