

MISSISSIPPI DEPARTMENT OF NATURAL RESOURCES
Bureau of Land and Water Resources
 Southport Mall
 P.O. Box 10631
 Jackson, Mississippi 39209
WATER WELL DRILLERS LOG

Harrison
N
2039

7/6 1982 Lyman Well Co. Harrison County
 date well completed firm name county well located

LANDOWNER: Debra Wrooman
Rt. 3, Box 81
Pass Christian, Miss
 (mailing address) 39571

description of formations encountered	from	to
<u>Sand Gravel</u>	<u>0</u>	<u>100</u>
<u>Blue Gumbo</u>	<u>100</u>	<u>200</u>
<u>Clay</u>		
<u>Good Sand</u>	<u>200</u>	<u>258</u>

WELL LOCATION:
 sec. 10 T. E N. R. 13 E
2 miles (distance) N (direction) of Areville (nearest town)

WELL PURPOSE: Home
 (home, irrigation, municipal, industrial)

- WELL COMPLETION DATA:
- (1) diameter (inches) 2"
 - (2) total depth (feet) 258
 - (3) static water level (feet) 71 below top of ground. above
 - (4) casing PVC 248
 (material) (depth)
2" if telescope see back.
 (size)
 - (5) screen 10' 258
 (length) (depth to top)
2" PVC
 (size) (material)
 - (6) pump 4 15
 (HP) (yield gpm)
Elect.
 (type power)
 - (7) electric log NO
 (yes or no)
NO.
 (organization running log)
 - (8) how well bottom plugged Sand
Shank


DRILLERS REMARKS:

DEPT. OF NATURAL RESOURCES
 BUREAU OF LAND & WATER RESOURCES

JUL 20 1982
RECEIVED

If well telescopes please sketch and show depths.

GROUND LEVEL

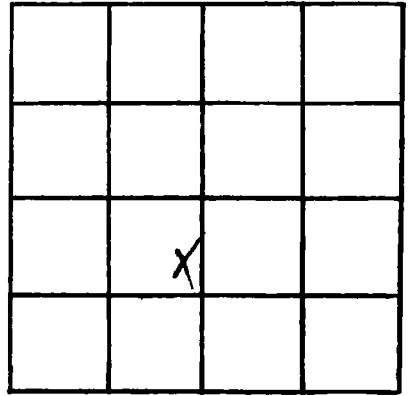

SECTION 10

Please indicate well location X.

ADDITIONAL INFORMATION

If more than one screen, show locations of each on sketch.