

MISSISSIPPI DEPARTMENT OF NATURAL RESOURCES
Bureau of Land and Water Resources
 Southport Mall
 P.O. Box 10631
 Jackson, Mississippi 39209
WATER WELL DRILLERS LOG

Harrison
N
2041

7/9 1982 Hyman Well Co. Harrison County
 date well completed firm name county well located

LANDOWNER: James Stone
Rt 3, Box 80
Pass Christian, Miss
 (mailing address) 39571

description of formations encountered	from	to
<u>Sand Gravel</u>	<u>0</u>	<u>100</u>
<u>Blue Clay</u>	<u>100</u>	<u>200</u>
<u>Good sand</u>	<u>200</u>	<u>358</u>

WELL LOCATION:
 sec 10 T 8 N R 13 E
2 miles N of Pineville
 (distance) (direction) (nearest town)

WELL PURPOSE: HOME
 (home, irrigation, municipal, industrial)

- WELL COMPLETION DATA:
- (1) diameter (inches) 2"
 - (2) total depth (feet) 258
 - (3) static water level (feet) 7.1 below above
 top of ground.
 - (4) casing PVC 248,
 (material) (depth)
2"
 (size) If telescope see back.
 - (5) screen 10' 258
 (length) (depth to top)
2" PVC
 (size) (material)
 - (6) pump 3/4 15
 (HP) (yield gpm)
Elect.
 (type power)
 - (7) electric log NO
 (yes or no)
NO
 (organization running log) Sand Shark
 - (8) how well bottom plugged Sand Shark

DEPT. OF NATURAL RESOURCES
 BUREAU OF LAND & WATER RESOURCES


JUL 20 1982

RECEIVED

DRILLERS REMARKS:

If well telescopes please sketch and show depths.

GROUND LEVEL

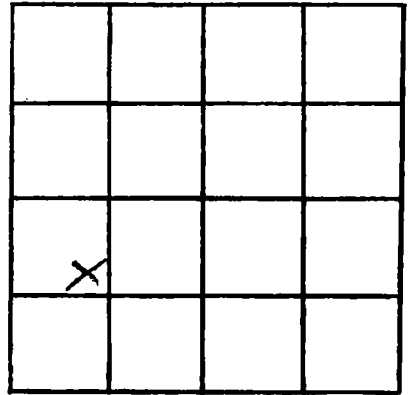

SECTION 10

Please indicate well location X.

ADDITIONAL INFORMATION

Lined area for entering additional information.

If more than one screen, show locations of each on sketch.