

MISSISSIPPI DEPARTMENT OF NATURAL RESOURCES

Bureau of Land and Water Resources

Southport Mall

P.O. Box 10631

Rev 8/2/82

Jackson, Mississippi 39209

WATER WELL DRILLERS LOG

Harrison
N
2042

7-19-82 BRADEN Pumpwell

HARRISON
~~HARRISON~~
county well located

date well completed

firm name SERVICE, INC.

county well located


LANDOWNER: CLYDE BELL SR.	description of formations encountered	from	to
Fairway Drive, Bay Colony Pass Christian, Miss. 39591 (mailing address)			
WELL LOCATION: sec 27 T 8 N R 13 W 1 miles W of Pass Christian (distance) (direction) (nearest town)	Clay	0	5
WELL PURPOSE: Sprinkler System (home, irrigation, municipal, industrial)	Sand	5	20
WELL COMPLETION DATA: (1) diameter (inches) 2"	CLAY	20	30
(2) total depth (feet) 635 ft.	SAND	30	40
(3) static water level (feet) 10 below above top of ground.	CLAY	40	55
(4) casing PVC 625 (material) (depth)	SAND	55	60
2" (size) if telescope see back.	CLAY	60	120
(5) screen 10 ft 625 (length) (depth to top)	SAND	120	160
2" PVC (size) (material)	CLAY	160	170
(6) pump 1 20 (HP) (yield gpm)	SAND	170	240
3200 1/2 (type power)	CLAY	240	320
(7) electric log No (yes or no)	Spt SAND	320	340
(organization running log)	CLAY	340	400
(8) how well bottom plugged 2" Sand Shank	SAND	400	406
DRILLERS REMARKS: No Tail Pipe	CLAY	406	476
	SAND	476	480
	CLAY	480	600
	SAND	600	635

DEPT. OF NATURAL RESOURCES
BUREAU OF LAND & WATER RESOURCES

JUL 20 1982
RECEIVED

If well telescopes please sketch and show depths.

GROUND LEVEL

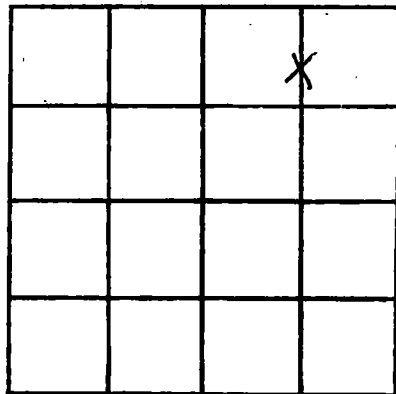

SECTION 27

Please indicate well location X.

ADDITIONAL INFORMATION

If more than one screen, show locations of each on sketch.