

MISSISSIPPI DEPARTMENT OF NATURAL RESOURCES

Bureau of Land and Water Resources

Southport Mall

P.O. Box 10631

Jackson, Mississippi 39209

WATER WELL DRILLERS LOG

Harrison  
N  
2043

July 27 1982 Duncan Well Drilling Harrison  
Date well completed firm name county well located

LANDOWNER: Jay Triche  
P.O. 309  
Bay St. Louis, Ms.  
(mailing address)

description of formations encountered	from	to
Mud & Sand	0	65
Blue Clay	65	188
Yew Sand	188	240
Blue Clay	240	290
Course Sand	290	315

WELL LOCATION:  
sec 35 T 8 N R 13 E  
5 (S) W (W)  
1/2 miles Pass Christian  
(distance) (direction) (nearest town)

WELL PURPOSE: Home  
(home, irrigation, municipal, industrial)

WELL COMPLETION DATA:

(1) diameter (inches) 8"

(2) total depth (feet) 315

(3) static water level (feet) 10' below above top of ground.

(4) casing PVC, 305,  
(material) (depth)  
(size) If telescope see back.

(5) screen 10', 305'  
(length) (depth to top)  
2", PVC  
(size) (material)

(6) pump \_\_\_\_\_ (HP) \_\_\_\_\_ (yield gpm)  
electric  
(type power)

(7) electric log \_\_\_\_\_ (yes or no)  
(organization running log)

(8) how well bottom plugged Sand  
Shark

DEPT. OF NATURAL RESOURCES  
BUREAU OF LAND & WATER RESOURCES


AUG 30 1982

RECEIVED

DRILLERS REMARKS:

If well telescopes please sketch and show depths.

GROUND LEVEL

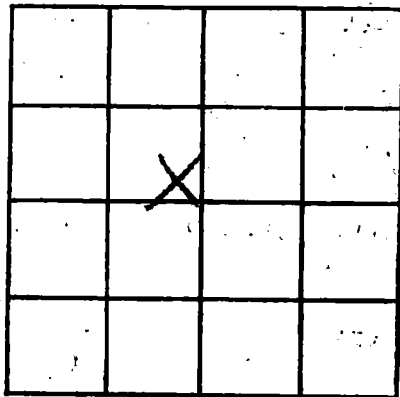

SECTION 35

Please indicate well location X.

ADDITIONAL INFORMATION

If more than one screen,  
show locations of each on sketch.