

MISSISSIPPI DEPARTMENT OF NATURAL RESOURCES

Bureau of Land and Water Resources

Southport Mall

P.O. Box 10631

Jackson, Mississippi 39209

WATER WELL DRILLERS LOG

Drum
N 2046
2

2-22-83 19 McMill Well Works Harrison
 date well completed firm name county well located

LANDOWNER: William Jore
1451 Rally Circle, Dept.
Well in Shoreline Park
 (mailing address)

description of formations encountered	from	to
<u>Mud Sand</u>	<u>0</u>	<u>130</u>
	<u>130</u>	<u>180</u>

WELL LOCATION:
 sec 39 T 8 N R 13 E
6 miles SW of Dept.
 (distance) (direction) (nearest town)

WELL PURPOSE: Home
 (home, irrigation, municipal, industrial)

WELL COMPLETION DATA:

- (1) diameter (inches) 2"
- (2) total depth (feet) 150'
- (3) static water level (feet) 9' below above top of ground.
- (4) casing Sch 40 P.V.C. 140'
 (material) (depth)
- 2"
 (size) If telescope see back.
- (5) screen 10' 140'
 (length) (depth to top)
- 2" Sch 40 P.V.C.
 (size) (material)
- (6) pump 1 10
 (HP) (yield gpm)
- electric
 (type power)
- (7) electric log —
 (yes or no)
- (organization running log)
- (8) how well bottom plugged sand
seal

DEPT. OF NATURAL RESOURCES
 BUREAU OF LAND & WATER RESOURCES


NOV 10 1983

RECEIVED

DRILLERS REMARKS:

If well telescopes please sketch and show depths.

GROUND LEVEL

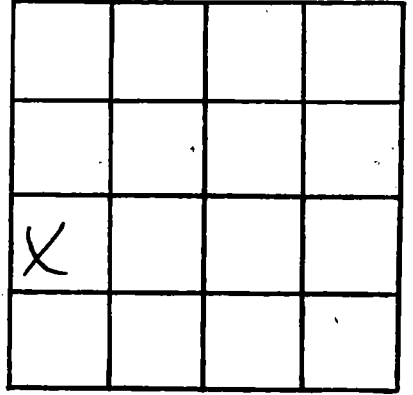

SECTION 39

Please indicate well location X.

ADDITIONAL INFORMATION

If more than one screen, show locations of each on sketch.