

MISSISSIPPI DEPARTMENT OF NATURAL RESOURCES

Bureau of Land and Water Resources

Southport Mall

P.O. Box 10631

Jackson, Mississippi 39209

WATER WELL DRILLERS LOG

Hanson
N
2049

April 27 19 83 Duncan Well Drilling Forrest
date well completed firm name county well located

LANDOWNER: <u>Charles Medeauf</u> <u>Rt. 3</u>	description of formations encountered	from	to
<u>Pass Christian</u> (mailing address)	<u>clay</u>	<u>0</u>	<u>20</u>
	<u>Clay + Sand</u>	<u>20</u>	<u>25</u>
	<u>good Sand</u>	<u>75</u>	<u>100</u>
<p>WELL LOCATION: sec. <u>8</u> T. <u>8</u> N. R. <u>13</u> E. (distance) <u>5</u> miles (direction) <u>S</u> of (nearest town) <u>W</u></p>			
<p>WELL PURPOSE: (home, irrigation, municipal, industrial)</p>			
<p>WELL COMPLETION DATA:</p>			
<p>(1) diameter (inches) <u>2"</u></p>			
<p>(2) total depth (feet) <u>100 ft.</u></p>			
<p>(3) static water level (feet) <u>5'</u> below above top of ground.</p>			
<p>(4) casing <u>PVC</u> <u>90</u> (material) (depth) (size) If telescope see back.</p>			
<p>(5) screen <u>10'</u> <u>90</u> (length) (depth to top)</p>			
<p><u>2"</u> <u>PVC</u> (size) (material)</p>			
<p>(6) pump (HP) (yield gpm)</p>			
<p>(type power)</p>			
<p>(7) electric log (yes or no)</p>			
<p>(organization running log)</p>			
<p>(8) how well bottom plugged <u>sand</u> <u>shank</u></p>			
<p>DRILLERS REMARKS: <u>installed</u> <u>owners pump</u></p>			


DEPT. OF NATURAL RESOURCES
BUREAU OF LAND & WATER RESOURCES

AUG 12 1983

RECEIVED

If well telescopes please sketch and show depths.

GROUND LEVEL

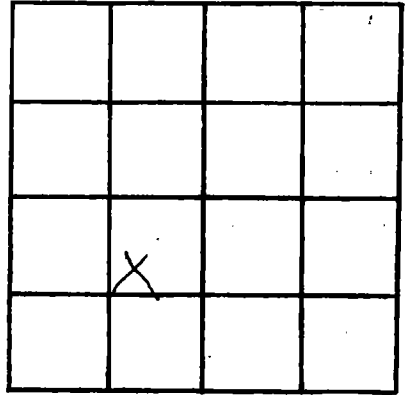

SECTION 8

Please indicate well location X.

ADDITIONAL INFORMATION

If more than one screen, show locations of each on sketch.