

MISSISSIPPI DEPARTMENT OF NATURAL RESOURCES
Bureau of Land and Water Resources
 Southport Mall
 P.O. Box 10631
 Jackson, Mississippi 39209
WATER WELL DRILLERS LOG

Harrison
N
2050

May 25 19 83 McMill Well Inc. Harrison
 date well completed firm name county well located

LANDOWNER: S. Murray
241 Clark Ave.
Pat Ch., MS
 (mailing address)

WELL LOCATION:
 sec. 13 T. 8 N. R. 13 E.
2 miles S of Passch
 (distance) (direction) (nearest town)

WELL PURPOSE: home
 (home, irrigation, municipal, industrial)

WELL COMPLETION DATA:

- (1) diameter (inches) 2"
- (2) total depth (feet) 390'
- (3) static water level (feet) 40' ^{below} above top of ground.
- (4) casing 40 PVC, 380'
 (material) (depth)
— if telescope see back.
 (size)
- (5) screen 10' 380
 (length) (depth to top)
2" 80 PVC 60st
 (size) (material)
- (6) pump 1 7
 (HP) (yield gpm)
Electric
 (type power)
- (7) electric log no
 (yes or no)
- (organization running log)
- (8) how well bottom plugged sand shark

description of formations encountered	from	to
Sand	0	20
"	20	40
Sand & Mud	40	60
mud	60	80
"	80	100
"	100	120
"	120	140
"	140	160
"	160	180
"	180	200
"	200	220
"	220	240
"	240	260
Sand	260	280
mud	280	300
"	300	320
"	320	340
"	340	360
Sand	360	380
Sand	380	390

DEPT. OF NATURAL RESOURCES
 BUREAU OF LAND & WATER RESOURCES


AUG 10 1983

RECEIVED

DRILLERS REMARKS:

If well telescopes please sketch and show depths.

GROUND LEVEL

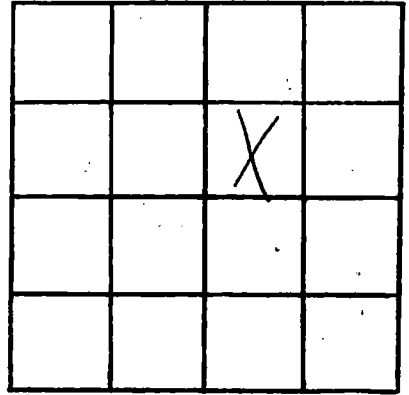

SECTION 13

Please indicate well location X.

ADDITIONAL INFORMATION

Lined area for additional information.

If more than one screen, show locations of each on sketch.