

Harrison
N
2053

MISSISSIPPI
 BOARD OF WATER COMMISSIONERS
 416 North State Street
 Jackson, Mississippi 39201

WATER WELL DRILLERS LOG
 MCGILWELL WORKS, INC.

5-28 1983
 date well completed

RT 1 BOX 222 D
 GULFPORT, MS 39501

Harrison
 county well located

LANDOWNER: Ondie Sadner
P.O. Box 293
Pass Christian Ms
 (mailing address)

description of formations encountered	from	to
<u>Mud</u>	<u>0</u>	<u>180</u>
<u>Sand</u>	<u>180</u>	<u>220</u>
<u>Mud</u>	<u>220</u>	<u>240</u>
<u>Sand</u>	<u>240</u>	<u>280</u>

WELL LOCATION:
 sec. 27 T 8 N R 13 E
4 miles S of PIC
 (distance) (direction) (nearest town)

WELL PURPOSE: home
 (home, irrigation, municipal, industrial)

- WELL COMPLETION DATA:
- (1) diameter (inches) 2"
 - (2) total depth (feet) 280
 - (3) static water level (feet) 40' ^{below} above top of ground.
 - (4) casing 40 PVC, 270
 (material) (depth)
 - (size) If telescope see back.
 - (5) screen 10',
 (length) (depth to top)
2", 80 PVC, 6 slot
 (size) (material)
 - (6) pump 1,
 (HP) (yield gpm)
Electric
 (type power)
 - (7) electric log no
 (yes or no)
 (organization running log)
 - (8) how well bottom plugged sand seal

DRILLERS REMARKS:


DEPT. OF NATURAL RESOURCES
 BUREAU OF LAND & WATER RESOURCES

AUG 9 1983

RECEIVED

If well telescopes please sketch and show depths.

GROUND LEVEL

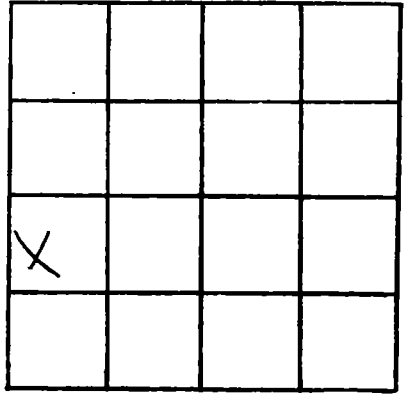

SECTION 18

Please indicate well location X.

ADDITIONAL INFORMATION

If more than one screen, show locations of each on sketch.