

MISSISSIPPI DEPARTMENT OF NATURAL RESOURCES  
 Bureau of Land and Water Resources  
 Southport Mall  
 P.O. Box 10631

Jackson, Mississippi 39209  
**WATER WELL DRILLERS LOG**

**COASTAL DRILLING & SERVICE CO.**

ROUTE 1 BOX 618

BILOXI, MISS. 39532

*Harrison*  
 county well located

*Harrison*  
 N  
 2058

11/9/83  
 date well completed

LANDOWNER: *P. P. Vogt*  
*Rt 4 Box 332*  
*Posey Cheston MS*  
 (mailing address)

WELL LOCATION:  
 sec. *16* T. *8* N. R. *13* E  
*Delisle*  
 (distance) (direction) of (nearest town)

WELL PURPOSE: *Home*  
 (home, irrigation, municipal, industrial)

WELL COMPLETION DATA:

- (1) diameter (inches) *2"*
- (2) total depth (feet) *410'*
- (3) static water level (feet) *25'* below above top of ground.
- (4) casing *PVC* *400'*  
 (material) (depth)  
 (size) If telescope see back.
- (5) screen *10'* *400'*  
 (length) (depth to top)  
*2"* *PVC*  
 (size) (material)
- (6) pump *None* *15*  
 (HP) (yield gpm)  
*Electric*  
 (type power)
- (7) electric log *Yes*  
 (yes or no)

(organization running log)

(8) how well bottom plugged  
*2" sand with valve*

DRILLERS REMARKS: *19-B*

description of formations encountered	from	to
<i>Top Soil</i>	<i>1</i>	<i>3</i>
<i>White Sand</i>	<i>3</i>	<i>44</i>
<i>Grey Sand</i>	<i>44</i>	<i>80</i>
<i>Soft Blue Clay</i>	<i>80</i>	<i>260</i>
<i>Hard Blue Clay</i>	<i>260</i>	<i>375</i>
<i>Grey Water Sand</i>	<i>375</i>	<i>390</i>
<i>Grey Water Sand</i>	<i>390</i>	<i>410</i>


DEPT. OF NATURAL RESOURCES  
 BUREAU OF LAND AND WATER RESOURCES

JUN 28 1984

**RECEIVE**

If well telescopes please sketch and show depths.

GROUND LEVEL

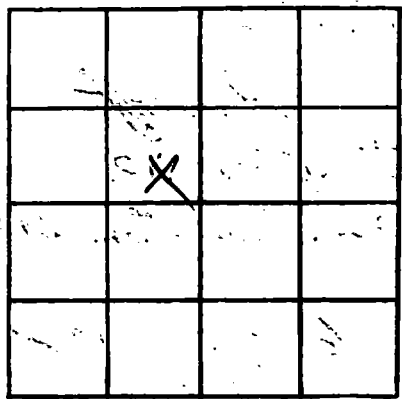

SECTION \_\_\_\_\_

Please indicate well location X.

ADDITIONAL INFORMATION

If more than one screen, show locations of each on sketch.