

HARRISON
N
2059

MISSISSIPPI DEPARTMENT OF NATURAL RESOURCES
 Bureau of Land and Water Resources
 Southport Mall
 P.O. Box 10631
 Jackson, Mississippi 39209
WATER WELL DRILLERS LOG

Jan. 11 1984 Henson Well Drilling Harrison
 date well completed firm name county well located

LANDOWNER: Marlin Cook
Rt. 3 Box 770
Pasadena, Ms.
 (mailing address)

description of formations encountered	from	to
<u>Clay</u>	<u>0</u>	<u>20</u>
<u>Sand + gravel</u>	<u>20</u>	<u>120</u>
<u>Blue Clay</u>	<u>120</u>	<u>170</u>
<u>fine sand</u>	<u>170</u>	<u>220</u>
<u>course sand</u>	<u>220</u>	<u>250</u>

WELL LOCATION:
 sec. 8 T. 8 N. R. 13 E.
S W
 miles 1/2 (distance) In. N. of Lake (direction) of nearest town

WELL PURPOSE: Home
 (home, irrigation, municipal, industrial)

- WELL COMPLETION DATA:
- (1) diameter (inches) 2"
 - (2) total depth (feet) 250'
 - (3) static water level (feet) 10' below/above top of ground.
 - (4) casing PVC (material), 240' (depth)
 (size) If telescope see back.
 - (5) screen 10' (length), 240' (depth to top)
2" (size), PVC (material)
 - (6) pump 1 (HP), 12 (yield gpm)
electric (type power)
 - (7) electric log (yes or no)
 (organization running log)
 - (8) how well bottom plugged Sand
Shank

DRILLERS REMARKS: _____


DEPT. OF NATURAL RESOURCES
 BUREAU OF LAND & WATER RESOURCES

FEB - 7 1984

RECEIVED

If well telescopes please sketch and show depths.

GROUND LEVEL

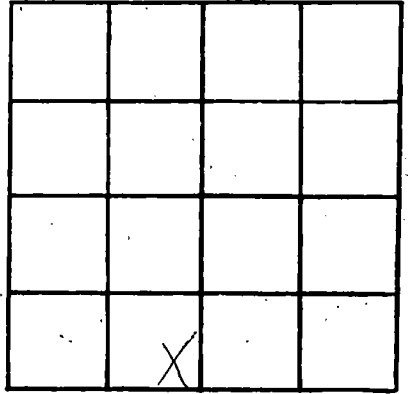

SECTION 8

Please indicate well location X.

ADDITIONAL INFORMATION

If more than one screen, show locations of each on sketch.