

**MISSISSIPPI DEPARTMENT OF NATURAL RESOURCES**  
**Bureau of Land and Water Resources**  
 Southport Mall  
 P.O. Box 10631  
 Jackson, Mississippi 39209  
**WATER WELL DRILLERS LOG**

Harrison
N
2061

2-7 1984 McGill Wells Inc HARRISON  
 date well completed                      firm name                      county well located

**LANDOWNER:** Lois McKenzie  
1611 BETTS STREET  
WIFPORT, MS 39501  
 (mailing address)

description of formations encountered	from	to
	<u>SAND</u>	<u>0</u>

**WELL LOCATION:**  
 sec. 22 T. 8 N R. 13 E  
2 miles West of LOSS CH.  
 (distance) (direction) (nearest town)

**WELL PURPOSE:** HOME  
 (home, irrigation, municipal, industrial)

- WELL COMPLETION DATA:**
- (1) diameter (inches) 2"
  - (2) total depth (feet) 30'
  - (3) static water level (feet) 2 below above top of ground.
  - (4) casing 40 PVC, 30'  
 (material) (depth)  
 (size) if telescope see back.
  - (5) screen 10', 30'  
 (length) (depth to top)  
2", 80 PVC, 50/80/6  
 (size) (material) 5/8"
  - (6) pump 1/2, 8  
 (HP) (yield gpm)  
Electric  
 (type power)
  - (7) electric log NO  
 (yes or no)  
 (organization running log)
  - (8) how well bottom plugged Capped


**DRILLERS REMARKS:**

DEPT. OF NATURAL RESOURCES  
 BUREAU OF LAND & WATER RESOURCES

MAR - 6 1984  
**RECEIVED**

If well telescopes please sketch and show depths.

GROUND LEVEL

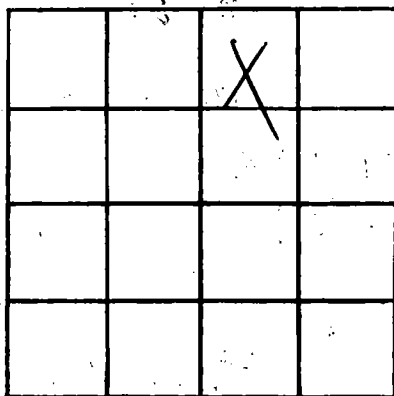

SECTION 22

Please indicate well location X.

ADDITIONAL INFORMATION

If more than one screen, show locations of each on sketch.