

**MISSISSIPPI DEPARTMENT OF NATURAL RESOURCES**  
**Bureau of Land and Water Resources**  
 Southport Mall  
 P.O. Box 10631  
 Jackson, Mississippi 39209  
**WATER WELL DRILLERS LOG**

Harrison  
N  
2063

3-27-84 date well completed      Mobile Wells Harrison firm name      \_\_\_\_\_ county well located

LANDOWNER: Harry Rivers  
Pt. 3 Box 503  
Bay St. Louis, Miss.  
 (mailing address)

WELL LOCATION:  
 sec. 19 T. 8 N. R. 13 E.  
4 miles NW of B.S. Loui  
 (distance) (direction) (nearest town)

WELL PURPOSE: private  
 (home, irrigation, municipal, industrial)

- WELL COMPLETION DATA:
- (1) diameter (inches) 2"
  - (2) total depth (feet) 180'
  - (3) static water level (feet) 15' <sup>below</sup> <sub>above</sub> top of ground.
  - (4) casing 40 PVC 170'  
 (material) (depth)
  - \_\_\_\_\_ If telescope see back.  
 (size)
  - (5) screen 10' 170'  
 (length) (depth to top)
  - 2" 40 PVC  
 (size) (material)
  - (6) pump \_\_\_\_\_  
 (HP) (gpm)
  - \_\_\_\_\_ (type power)
  - (7) electric log no  
 (yes or no)
  - \_\_\_\_\_ (organization running log)
  - (8) how well bottom plugged hand seal

| description of formations encountered | from       | to         |
|---------------------------------------|------------|------------|
| <u>mud</u>                            | <u>0</u>   | <u>20</u>  |
| <u>sand</u>                           | <u>20</u>  | <u>40</u>  |
| <u>mud</u>                            | <u>40</u>  | <u>80</u>  |
| <u>sand</u>                           | <u>80</u>  | <u>100</u> |
| <u>mud</u>                            | <u>100</u> | <u>120</u> |
| <u>sand</u>                           | <u>120</u> | <u>140</u> |
| <u>mud</u>                            | <u>140</u> | <u>160</u> |
| <u>lime sand</u>                      | <u>160</u> | <u>170</u> |
| <u>clay sand</u>                      | <u>170</u> | <u>180</u> |

DEPT. OF NATURAL RESOURCES  
 BUREAU OF LAND & WATER RESOURCES


APR - 5 1984

**RECEIVED**

DRILLERS REMARKS: \_\_\_\_\_

If well telescopes please sketch and show depths.

GROUND LEVEL

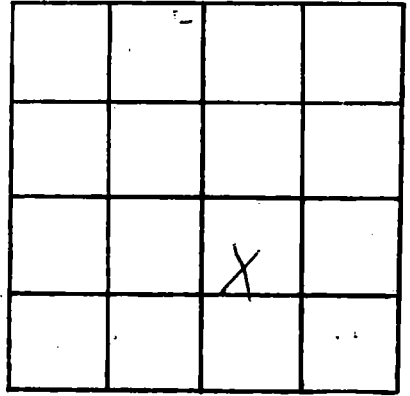

SECTION 19

Please indicate well location X.

ADDITIONAL INFORMATION

A series of horizontal lines for writing additional information, starting below the 'ADDITIONAL INFORMATION' header and extending to the bottom of the page.

If more than one screen, show locations of each on sketch.