

HARRISON  
 N 2064

MISSISSIPPI DEPARTMENT OF NATURAL RESOURCES  
 Bureau of Land and Water Resources  
 Southport Mall  
 P.O. Box 10631  
 Jackson, Mississippi 39209  
**WATER WELL DRILLERS LOG**

3-28-84 19 McGill Well Works HARRISON  
 date well completed firm name county well located

LANDOWNER: 388-84

Mrs. Ulrich

D.C. Mo  
 (mailing address)

WELL LOCATION:

sec. 22 T. 8 N. R. 13 E  
2 miles SW of DC  
 (distance) (direction) (nearest town)

WELL PURPOSE:

(home, irrigation, municipal, industrial)

WELL COMPLETION DATA:

- (1) diameter (inches) 2"  
 (2) total depth (feet) 640'  
 (3) static water level (feet) 90' <sup>below</sup> <sub>above</sub> top of ground.  
 (4) casing 2" 630'  
 (material) (depth)

- If telescope see back.  
 (size)

- (5) screen 10' 630'  
 (length) (depth to top)  
2" SCH 80 PVC  
 (size) (material)

- (6) pump 1 9  
 (HP) (yield gpm)

electric  
 (type power)

- (7) electric log NO  
 (yes or no)

(organization running log)

- (8) how well bottom plugged Sand Seal

DRILLERS REMARKS:


description of formations encountered	from	to
Mud	0	40
Mud & SAND	40	60
SAND	60	120
Mud	120	140
Mud & SAND	140	180
SAND	180	200
Mud & SAND	200	220
SAND	220	340
Mud	340	380
Sand	380	400
Sand	400	440
MUD	440	640
Sand	640	1040

DEPT. OF NATURAL RESOURCES  
 BUREAU OF LAND & WATER RESOURCES

JUL 10 1984  
**RECEIVED**

If well telescopes please sketch and show depths.

GROUND LEVEL

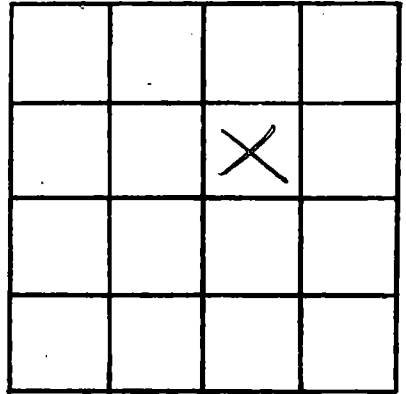

SECTION 22

Please indicate well location X.

ADDITIONAL INFORMATION

A series of horizontal lines for writing additional information.

If more than one screen, show locations of each on sketch.