

Harrison  
N  
2067

MISSISSIPPI DEPARTMENT OF NATURAL RESOURCES  
 Bureau of Land and Water Resources  
 Southport Mall  
 P.O. Box 10631  
 Jackson, Mississippi 39209  
**WATER WELL DRILLERS LOG**

4-18-84 19 McNee Well Works Harrison  
 date well completed firm name county well located

LANDOWNER: D.D. Sigworth

Rd 4 Box 1162  
Pass Christian, ms.  
 (mailing address)

WELL LOCATION:

sec. 22 T. 8 N R. 13 E  
2 miles SW. of P.C.  
 (distance) (direction) (nearest town)

WELL PURPOSE: Home  
 (home, irrigation, municipal, industrial)

WELL COMPLETION DATA:

(1) diameter (inches) 2"  
 (2) total depth (feet) 350'  
 (3) static water level (feet) \_\_\_\_\_ below above top of ground.  
 (4) casing sch 40<sup>prc</sup>, 340'  
 (material) (depth)

(size) If telescope see back.

(5) screen 10', 340'  
 (length) (depth to top)  
2", sch 80  
 (size) (material)

(6) pump 1 9  
 (HP) (yield gpm)  
elec  
 (type power)

(7) electric log \_\_\_\_\_  
 (yes or no)

(organization running log)

(8) how well bottom plugged Sand Seal

DRILLERS REMARKS: \_\_\_\_\_

description of formations encountered

from to

Sand	0	30
mud	30	180
Sand	180	290
mud	290	300
Mudsand	300	330
Sand	330	350


DEPT. OF NATURAL RESOURCES  
 BUREAU OF LAND & WATER RESOURCES

JUN - 1 1984

RECEIVED

If well telescopes please sketch and show depths.

GROUND LEVEL

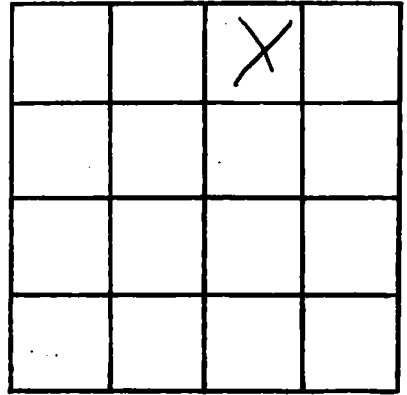

SECTION \_\_\_\_\_

Please indicate well location X.

ADDITIONAL INFORMATION

If more than one screen, show locations of each on sketch.