

MISSISSIPPI DEPARTMENT OF NATURAL RESOURCES

Bureau of Land and Water Resources

Southport Mall

P.O. Box 10631

Jackson, Mississippi 39209

WATER WELL DRILLERS LOG

Harrison
N
2069

5/8/84 date well completed McNeil Well Works firm name Harrison county well located

LANDOWNER: Kenneth Suge
Rt 3, Box 196
Pass Christian, Ms.
 (mailing address)

WELL LOCATION:
 sec 22 T 9 N R 13 E
1 miles W of P.C.
 (distance) (direction) (nearest town)

WELL PURPOSE: Agric.
 (home, irrigation, municipal, industrial)

WELL COMPLETION DATA:

(1) diameter (inches) 2"

(2) total depth (feet) 400'

(3) static water level (feet) 160 below top of ground. above

(4) casing Sch 40 (material), 390' (depth)
 (size) if telescope see back.

(5) screen 10' (length), 390' (depth to top)
2" (size), Sch 80 (material)

(6) pump 1 (HP), 10 (yield gpm)
elec. (type power)

(7) electric log --- (yes or no)
 (organization running log)

(8) how well bottom plugged Sand Seal.

description of formations encountered	from	to
Mud	0	60
Sand & Mud	60	80
Mud	80	140
Sand & Mud	140	160
Mud	160	240
Sand	240	280
Mud	280	320
Mud & Sand	320	380
Sand	380	400

DEPT. OF NATURAL RESOURCES
 BUREAU OF LAND & WATER RESOURCES


JUN - 1 1984

RECEIVED

DRILLERS REMARKS:

If well telescopes please sketch and show depths.

GROUND LEVEL

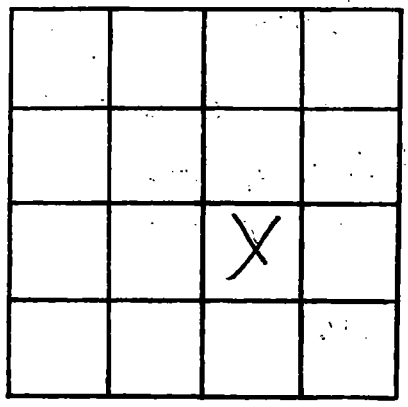

SECTION _____

Please indicate well location X.

ADDITIONAL INFORMATION

Lined area for additional information.

If more than one screen, show locations of each on sketch.