

Harrison  
N  
2071

MISSISSIPPI DEPARTMENT OF NATURAL RESOURCES  
Bureau of Land and Water Resources  
Southport Mall  
P.O. Box 10631  
Jackson, Mississippi 39209  
WATER WELL DRILLERS LOG

7-3-84 19 McMiss Wells Harrison  
date well completed firm name county well located

LANDOWNER: Jim Schmet  
Homes & Dome  
Pass Chr. Mo.  
(mailing address)

description of formations encountered	from	to
clay	0	180
clay & sand	180	220
sand	220	240
clay	240	260
clay & sand	260	280

WELL LOCATION:  
sec. 22 T 8 N R 13 E  
S W  
3 miles N of PC  
(distance) (direction) (nearest town)

WELL PURPOSE:  
(home, irrigation, municipal, industrial)

- WELL COMPLETION DATA:
- (1) diameter (inches) 2"
  - (2) total depth (feet) 280'
  - (3) static water level (feet) 25' below top of ground
  - (4) casing sch 40 PC 270'  
(material) (depth)
  - (size) if telescope see back.
  - (5) screen 10 270'  
(length) (depth to top)
  - 2" sch 40 PC  
(size) (material)
  - (6) pump 1 10  
(HP) (yield gpm)
  - elec  
(type power)
  - (7) electric log (yes or no)
  - (organization running log)
  - (8) how well bottom plugged Seal


DRILLERS REMARKS:

DEPT. OF NATURAL RESOURCES  
BUREAU OF LAND & WATER RESOURCES  
AUG 13 1984

RECEIVED

If well telescopes please sketch and show depths.

GROUND LEVEL

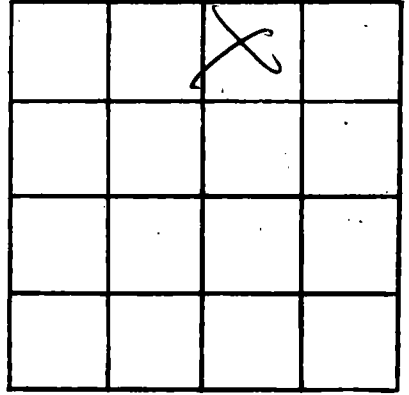

SECTION \_\_\_\_\_

Please indicate well location X.

ADDITIONAL INFORMATION

If more than one screen, show locations of each on sketch.